


# DONEGAL STUD STAGE 11D/12

## Stormwater - Minimum Floor Levels Report

Hugh Green Limited



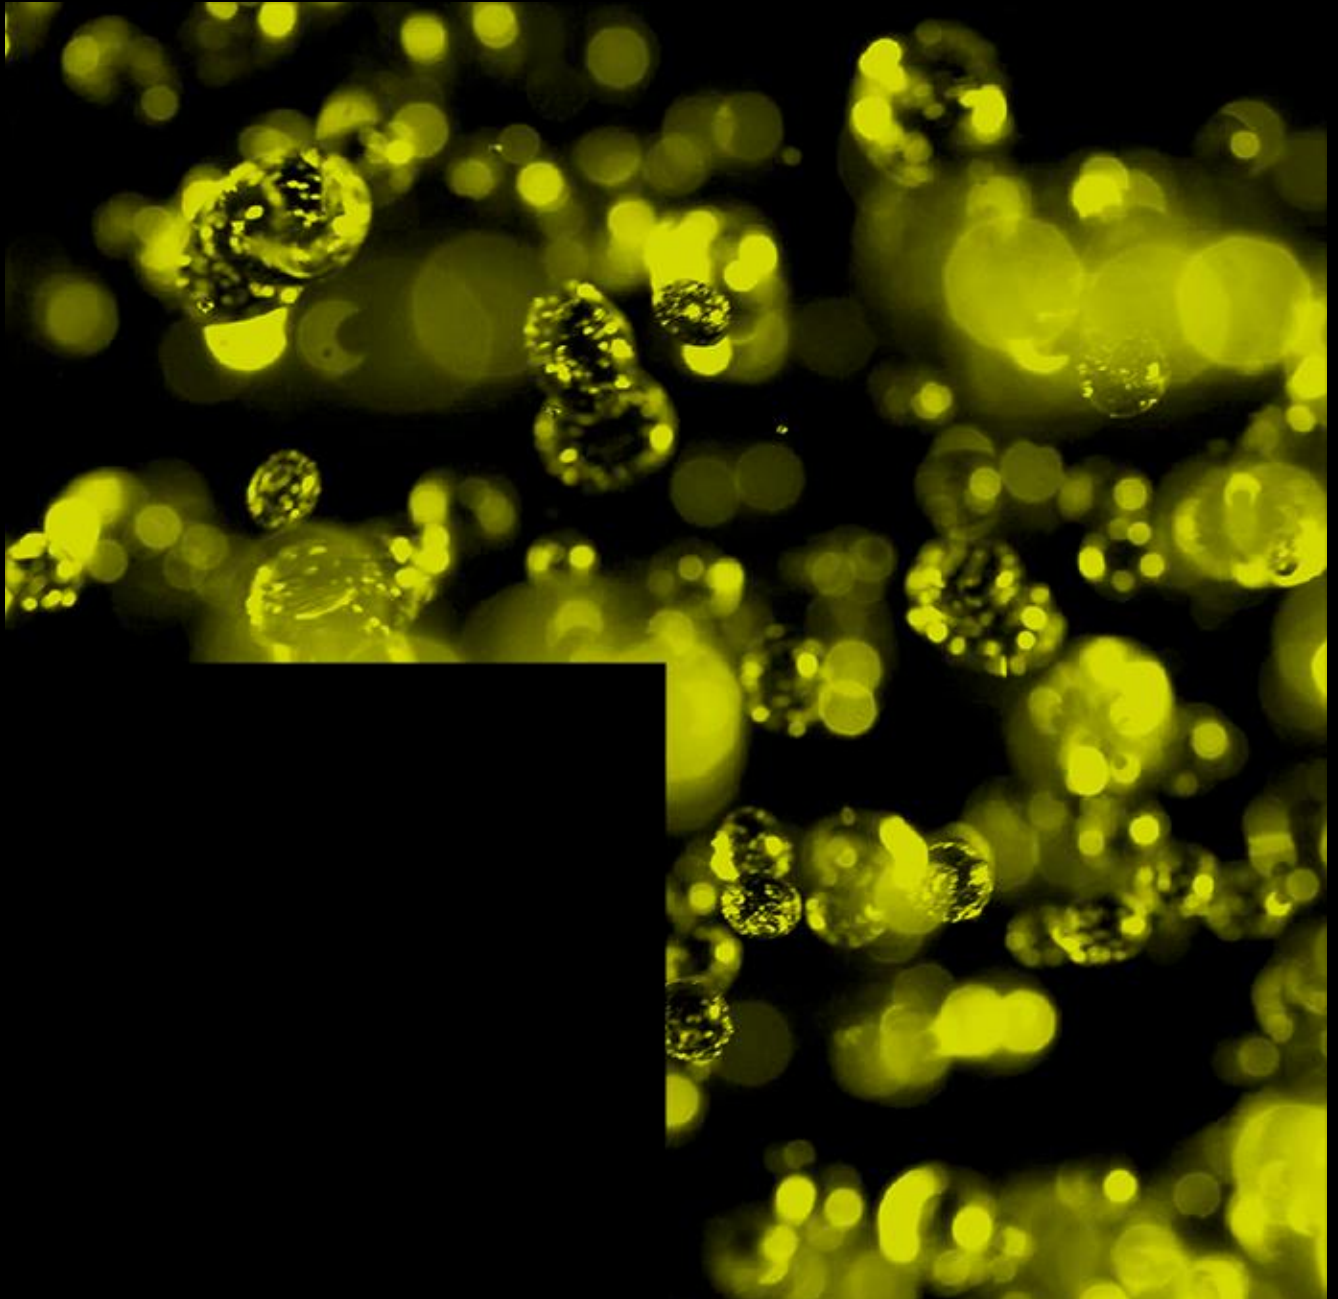

## DOCUMENT CONTROL RECORD

<b>CLIENT</b>	Hugh Green Limited
<b>PROJECT</b>	Donegal Stud Stage 11D/12
<b>HG PROJECT NO.</b>	1050-142875-01
<b>HG DOCUMENT NO.</b>	R001v1-142875-01-MFL-sxk
<b>DOCUMENT</b>	Stormwater Report – Minimum Floor Levels

## ISSUE AND REVISION RECORD

<b>DATE OF ISSUE</b>	11 August 2020
<b>STATUS</b>	Final

**ORIGINATOR**



---

Shane Kelly – Team Leader

**APPROVED FOR ISSUE**



---

Shane Kelly – Team Leader

**OFFICE OF ORIGIN**

Auckland

**TELEPHONE**

09 917 5000

**EMAIL**

s.kelly@harrisingrierson.com

# CONTENTS

<b>1.0</b>	<b>INTRODUCTION .....</b>	<b>1</b>
<b>2.0</b>	<b>RESPONSE TO REQUIREMENTS .....</b>	<b>2</b>
2.1	Identification of 1% AEP Flood Level .....	2
2.2	OLFP Layout Plan.....	2
2.3	As-Built Cross Sections .....	2
2.4	Identification of Private OLFP .....	2
2.5	Minimum Floor Levels .....	2
2.6	Obstructions in OLFP .....	3
<b>3.0</b>	<b>SUMMARY .....</b>	<b>4</b>

## APPENDICES

Appendix 1	Overland Flow Path & 1% AEP Asbuilt plans
Appendix 2	Overland Flow Asbuilt cross sections
Appendix 3	Overland Flow Calculations
Appendix 4	Minimum Floor Level Asbuilt plans

## 1.0 INTRODUCTION

This Stormwater Report has been prepared to fulfil the requirements of the Auckland Council Conditions of Consent 20 & 56 – Minimum Floor Levels (BUN60344688).

The purpose of the report is to satisfy the requirements set out under Condition 20 & 56 as follows:

- a) The 1% AEP flood level for the site and the surrounding road reserves;
- b) A layout plan of the overland flow paths for the site and the adjacent land along the boundary in accordance with the approved EPA before Section 223 approval;
- c) The overland flow path plan shall include as built cross sections of all roads including the ponding areas with levels before overtopping;
- d) As built longitudinal plan and cross sections for shall be provided for overland flow path locations;
- e) The minimum floor level of all habitable buildings must be at least 150mm for flows below 2m<sup>3</sup> per second and 100 mm deep and where flows exceed this, the minimum floor level of habitable buildings must be increased to at least 500mm. This may be enforced through a consent notice on the property unless the building consents have already been issued;
- f) No buildings, structures or other obstructions are to be erected in the overland flow paths without prior written permission from the Council; and
- g) Where either existing or proposed overland flow paths cross lot boundaries, the consent holder is to provide the Council with plans to accompany easement(s) to be registered in favour of the Council. Any easement documentation is to be prepared by the consent holder's lawyers to the satisfaction of the Council's solicitors. All costs are to be at the consent holder's expense. The terms of these easements must prevent buildings, structures or other obstructions being erected in the overland flow path, and must require the landowner to maintain, weed and clean the overland flow paths to ensure an unobstructed flow of stormwater.

## 2.0 RESPONSE TO REQUIREMENTS

### 2.1 IDENTIFICATION OF 1% AEP FLOOD LEVEL

#### 1% AEP – Road Flows

The secondary flows, up to and including the 1% AEP storm event, are contained within the road (i.e. kerb to kerb), as shown in Overland Flow Path As-built plans and cross section Drawing AB455-457, AB 465-469 in Appendix 1 & 2 for Roads 1, 2, 5, 11, 13 & 14 and JOALs.

#### 1% AEP – Flows outside the Road Reserve

There are two low deliberate low points on Road 1 and another on Road 2 where in a 1% AEP flood event, road flows may overspill the kerb on to the berm and are directed into the stormwater swales in the drainage reserves Lot 406 & 407 as shown in as-built drawing AB465-AB469 in Appendix 1. Road 2's flows will tip the kerb and flow into drainage reserve Lot 408. The flows from JOAL 2 Lot 201 will flow into Lot 6 where a shaped channel will run along the boundary and discharge into the drainage reserve Lot 403.

In a 1% AEP event of flooding over a 24-hour period, there are three locations where overland flows potentially overspill the kerb and discharge to the stream outside of the road reserve. The 1% AEP flood level at these discharge points is generated by cumulative overland flows from upstream future development catchments.

The OLFP overspill locations are shown in Appendix 4: 'Stage 11D & 12 Minimum Floor Level Asbuilt Plan'. The overland flows within the adjacent streams are contained within the stream banks. Adjacent finished floor levels (FFLs) are greater than 0.15m above the flood overtop level.

### 2.2 OLFP LAYOUT PLAN

A layout plan of the asbuilt OLFPs for this site and adjacent land along the boundary can be seen in As-built Drawing AB465-469 in Appendix 1.

### 2.3 AS-BUILT CROSS SECTIONS

The As-built cross-sections of all roads and swales in adjacent property including the ponding areas with levels before overtopping, depth, width, and velocity of flow can be seen in As-built Drawings AB455-457 in Appendix 2.

### 2.4 IDENTIFICATION OF PRIVATE OLFP

During the 1% AEP storm event, the overland flow along the road reserve does not overtop the kerb onto pavements or private property except for the overland flow from JOAL 2 and adjacent lots. As a result, there is an easement for private OLFP generated on lot 6 and the JOAL in favour of the 9 properties that jointly own the accessway. This is reflected in the 223 Land Transfer Survey plan submitted with this application.

### 2.5 MINIMUM FLOOR LEVELS

Where flows exceed 2m<sup>3</sup>/s, the minimum floor level of any habitable buildings must be 500mm above the 1% AEP flood level to comply with Chapter 4 of the Code of Practice for Land Development and Subdivision 2015. Overland flows generated from this subdivision are less than 2m<sup>3</sup>/s, so 150mm freeboard must be provided as a minimum.

In this residential subdivision there are 9 private lots (Lots 6, 7, 17, 18, 26, 32, 71, 39 & 40) that require minimum floor levels specified due to the 1% AEP flood event overtopping the kerb at Roads 1, 2 and JOAL 2 and discharging into reserve area, as shown Minimum Floor Level plans in Appendix 4.

## **2.6 OBSTRUCTIONS IN OLFP**

In this residential subdivision the overland flow is directed through the road reserve and overtops the kerb into reserve area from Roads 1 and 2 and through Lot 6. No buildings, structures or other obstructions can be erected in these areas without written permission from Auckland Council.

## 3.0 SUMMARY

This stormwater report for Minimum Floor Levels was prepared to satisfy Auckland Council Resource Consent (BUN60344688) specifically conditions 20 & 56. This report addresses how these conditions are met on the Donegal Stud Stage 11D & 12 residential subdivision.

The 1% AEP flood event is mostly contained within the road reserve, except for where it overtops the kerb and discharges to Council reserve areas at 3 locations and one more through a private lot. The overall layout plan in Appendix 1 and cross-sections in Appendix 2 show both the flow and depths of the overland flow through the road and swale sections. Appendix 3 is the calculations done for the overland flows. Appendix 4 specifies the minimum floor levels for the 9 lots potentially affected by overland flow overtopping the kerb. There is one private overland flow path that runs through lot 6 in favour of the 9 owners of the jointly owned accessway lot 201.



# APPENDICES






# **APPENDIX 1**

## **OVERLAND FLOW PATH & 1% AEP**

### **ASBUILT PLANS**

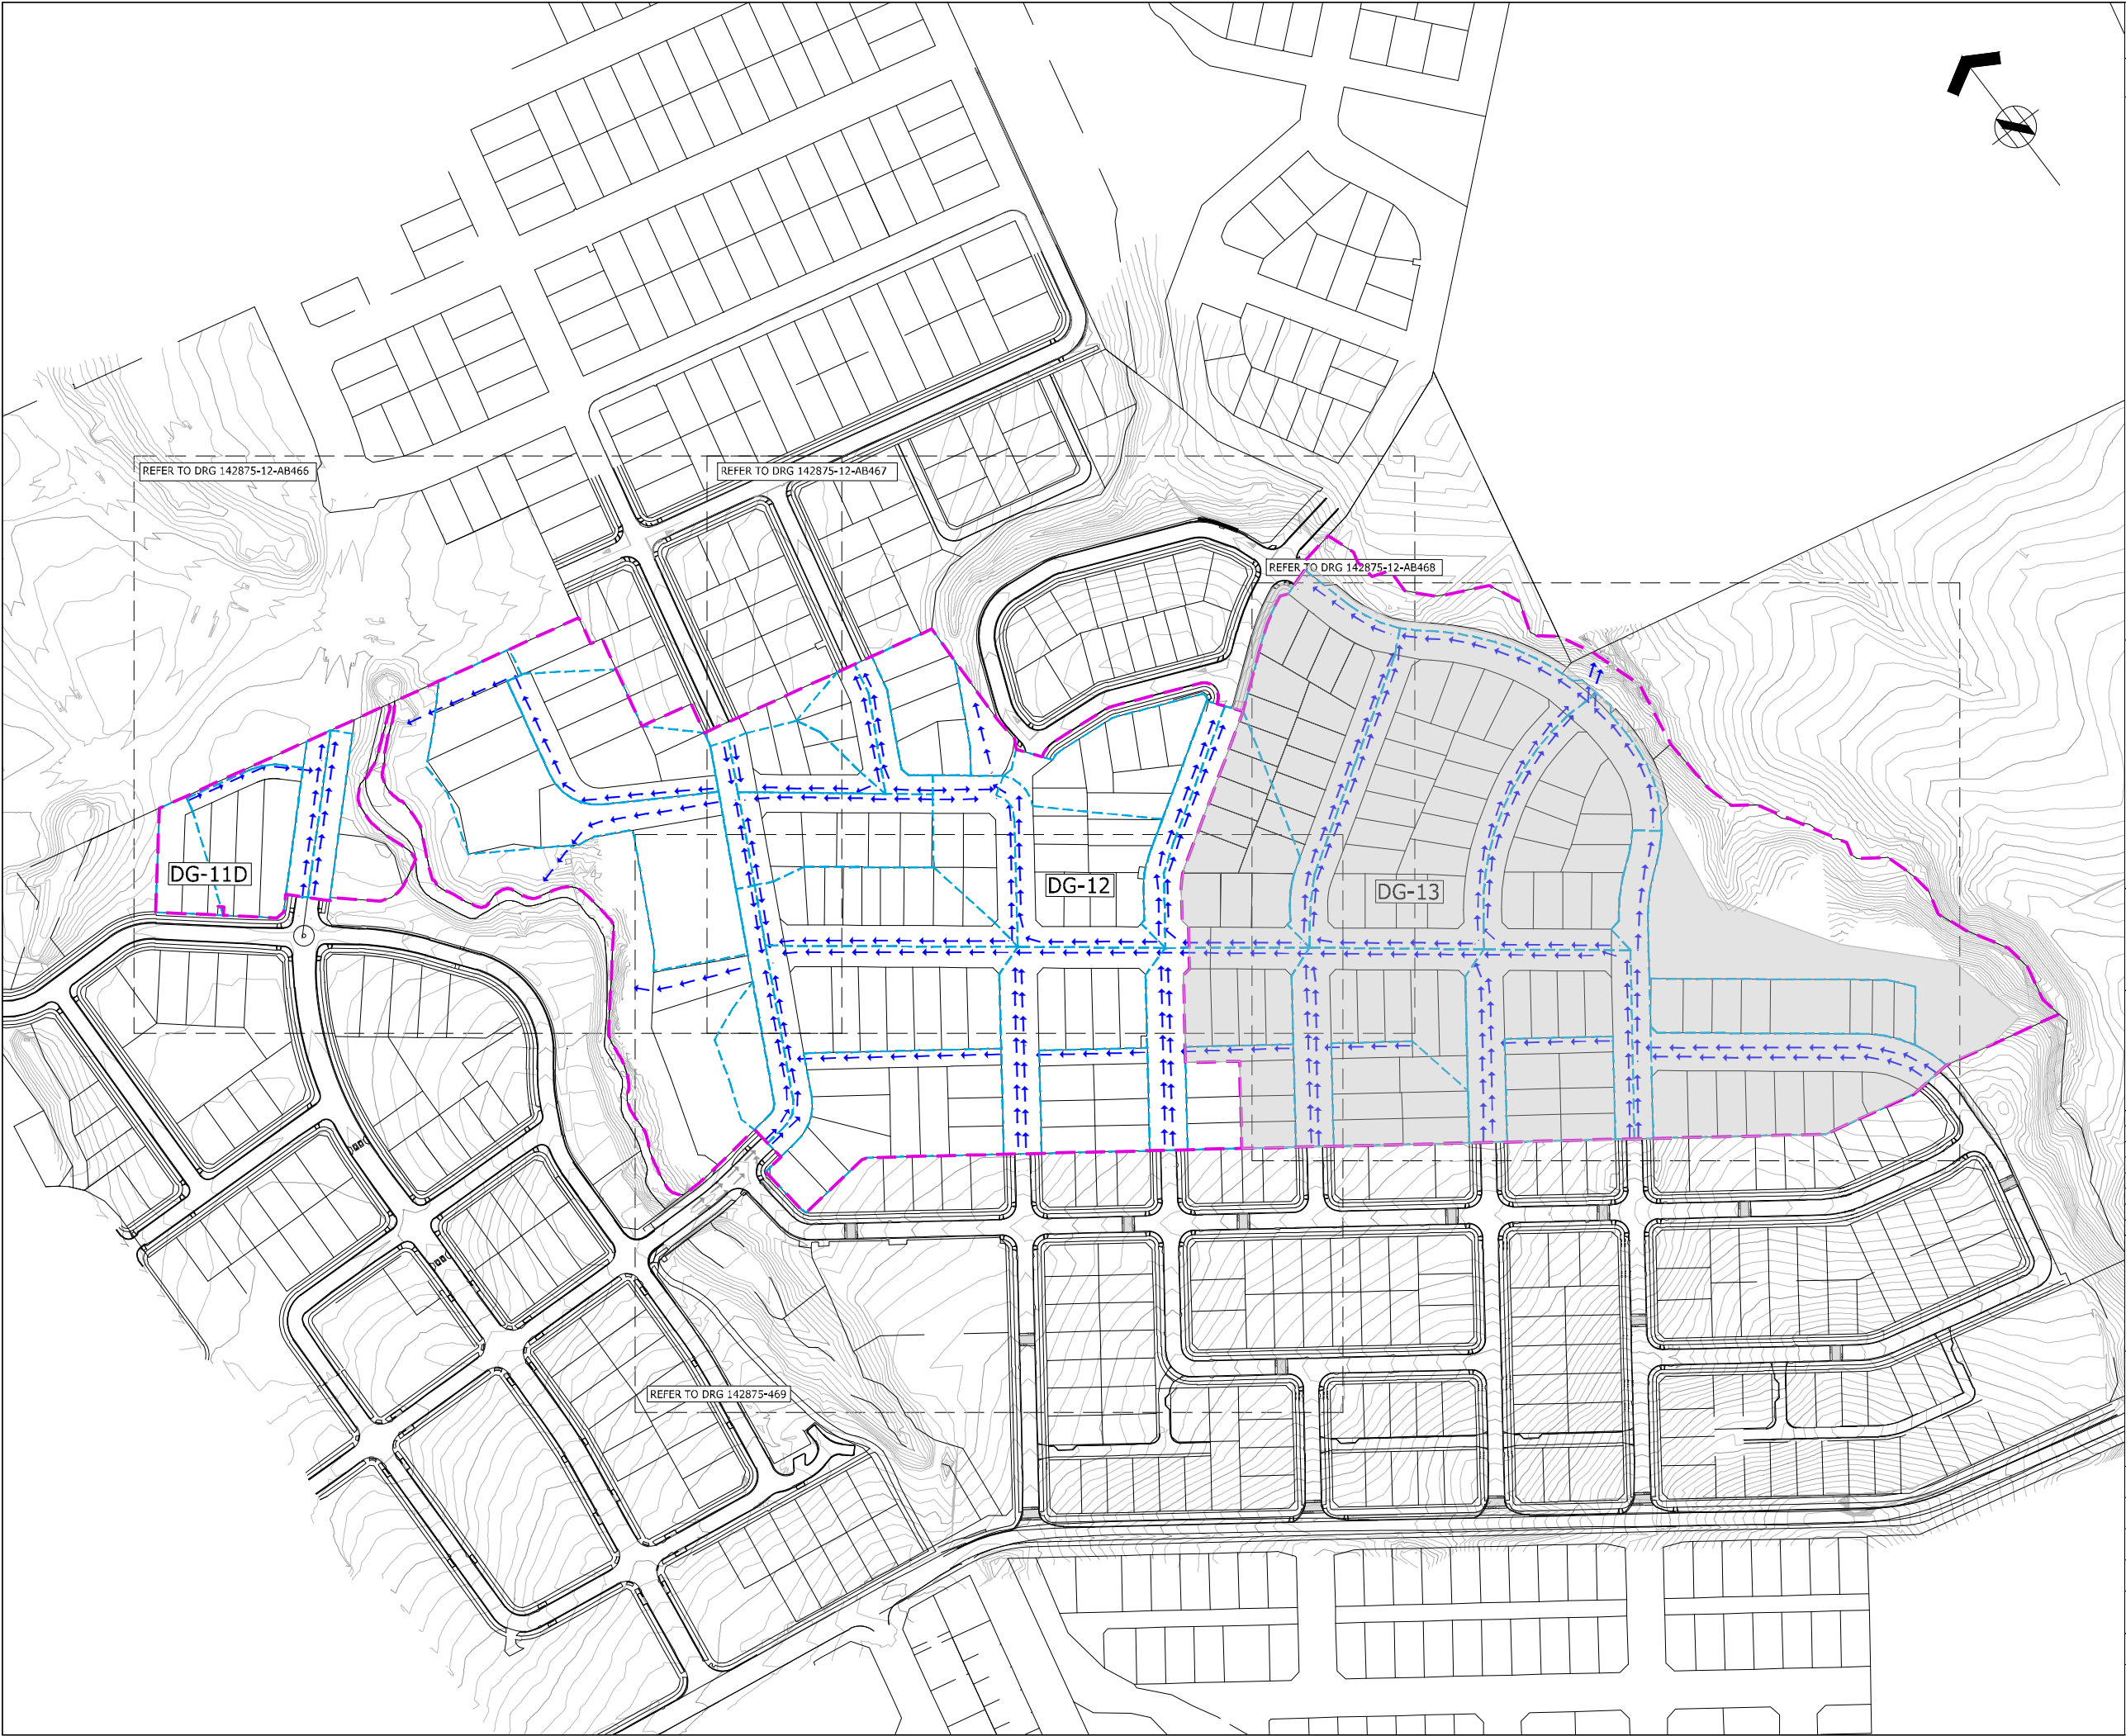




THIS DRAWING AND DESIGN REMAINS THE PROPERTY OF, AND MAY NOT BE REPRODUCED OR ALTERED, WITHOUT THE WRITTEN PERMISSION OF HARRISON GRIERSON CONSULTANTS LIMITED. NO LIABILITY SHALL BE ACCEPTED FOR UNAUTHORISED USE OF THIS DRAWING.

NOTES

1. REFER TO OVERLAND FLOW PATH ASBUILT CROSS SECTION DRAWINGS 142875-12-455 TO 457 FOR FLOWS AND VELOCITIES.

LEGEND

- 
- CATCHMENT BOUNDARIES
- 
- OVERLAND FLOWPATHS
- 
- STAGE BOUNDARIES

ENGINEERING APPROVAL  
EPA 60349136

I CERTIFY THAT THESE ASBUILT PLANS ARE AN ACCURATE RECORD OF THE WORKS UNDERTAKEN AND THAT:

- THE COORDINATES (X,Y) ARE IN TERMS OF NZTM ON NZGD (2000), AND ARE WITHIN ±50mm.
- THE LEVELS (Z) ARE IN TERMS OF THE AUCKLAND 1946 (MSL) LINZ DATUM (DOSLI DATUM), AND ARE WITHIN ±10mm.


Signed: .....  
CHARTERED PROFESSIONAL ENGINEER

Date: ...08/09/2020.....

Name: SHANE KELLY

Phone: 09-917-5000

Email: s.kelly@harrisingrierson.com



HUGH GREEN  
LIMITED



AUCKLAND OFFICE  
LEVEL 4, 96 ST GEORGES BAY ROAD  
PARNELL AUCKLAND 1052  
T +64 9 917 5000  
W www.harrisingrierson.com

1	ASBUILT	SXK	01.09.20
REF	REVISIONS	BY	DATE
PROJECT:			

HUGH GREEN LIMITED  
DONEGAL STAGE 11D/12  
36 TIR CONAILL AVENUE, FLAT BUSH

TITLE:  
100 YEAR OVERLAND FLOWPATH  
OVERALL ASBUILT PLAN


ORIGINATOR:	DATE:	SIGNED:	PLOT BY:
GKW	04.2019		SXK
DRAWN:	DATE:	SIGNED:	PLOT DATE:
SXK	01.09.20		09.09.20
CHECKED:	DATE:	SIGNED:	SURVEY BY:
SXK	01.09.20		
APPROVED:	DATE:	SIGNED:	SURVEY DATE:
SXK	01.09.20		

ISSUE STATUS:  
ASBUILT

PROJECT No:	SCALES:	A1
1050-142875-01	1:1500-A1 1:3000-A3	
DRAWING No:		REV

142875-12-AB465  
1



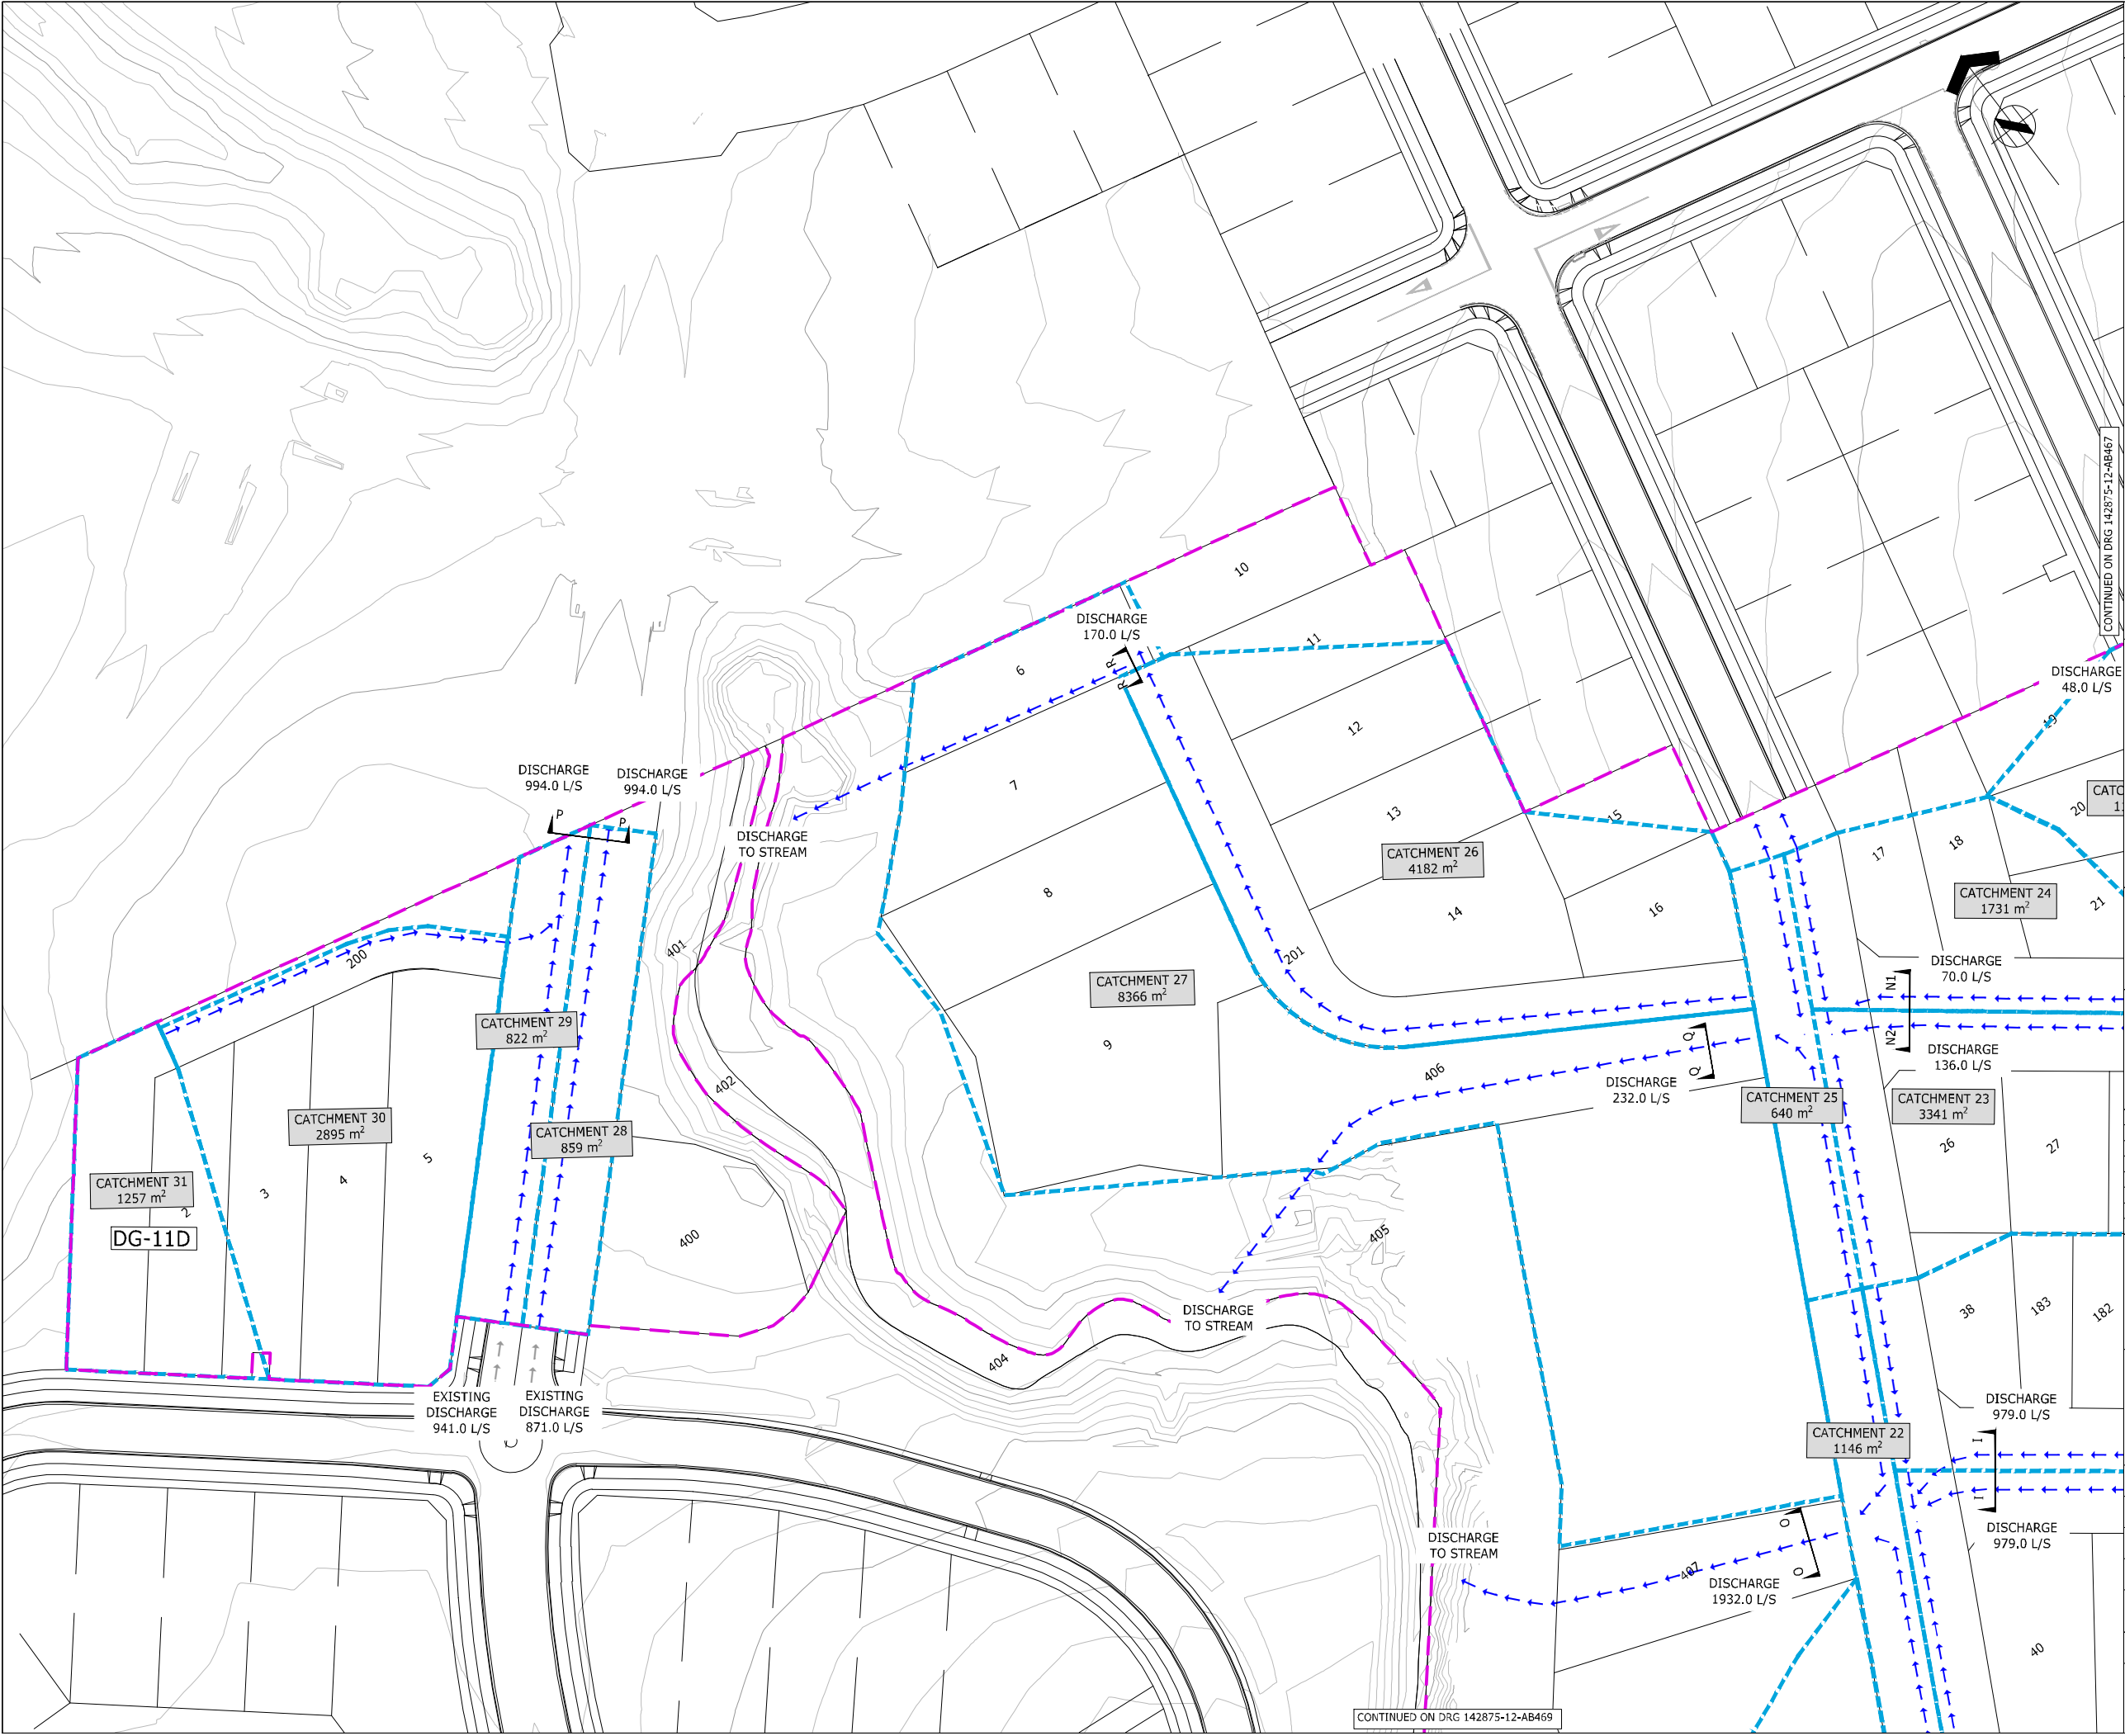



ASSOCIATION OF CONSULTING  
ENGINEERS NEW ZEALAND

ISO 9001  
QUALITY  
ASSURED

THIS DRAWING AND DESIGN REMAINS THE PROPERTY OF, AND MAY NOT BE REPRODUCED  
OR ALTERED, WITHOUT THE WRITTEN PERMISSION OF HARRISON GRIERSON CONSULTANTS  
LIMITED. NO LIABILITY SHALL BE ACCEPTED FOR UNAUTHORISED USE OF THIS DRAWING.

NOTES

1. REFER TO OVERLAND FLOW PATH ASBUILT CROSS  
SECTION DRAWINGS 142875-12-455 TO 457 FOR  
FLOWS AND VELOCITIES.

LEGEND

-----

CATCHMENT BOUNDARIES

→ → → →

OVERLAND FLOWPATHS

-----

STAGE BOUNDARIES

ENGINEERING APPROVAL  
EPA 60349136

I CERTIFY THAT THESE ASBUILT PLANS ARE AN ACCURATE RECORD OF  
THE WORKS UNDERTAKEN AND THAT:  
• THE COORDINATES (X,Y) ARE IN TERMS OF NZTM ON NZGD  
(2000), AND ARE WITHIN ±50mm.  
• THE LEVELS (Z) ARE IN TERMS OF THE AUCKLAND 1946 (MSL)  
LINZ DATUM (DOSLI DATUM), AND ARE WITHIN ±10mm.

Signed: .....  
CHARTERED PROFESSIONAL ENGINEER

Date: ...08/09/2020.....

Name: SHANE KELLY

Phone: 09-917-5000

Email: s.kelly@harrisongrierson.com



HUGH GREEN  
LIMITED



AUCKLAND OFFICE  
LEVEL 4, 96 ST GEORGES BAY ROAD  
PARNELL AUCKLAND 1052  
T +64 9 917 5000  
W www.harrisongrierson.com

1	ASBUILT	SXK	01.09.20
REF	REVISIONS	BY	DATE

PROJECT:

HUGH GREEN LIMITED  
DONEGAL STAGE 11D/12  
36 TIR CONAILL AVENUE, FLAT BUSH

TITLE:


100 YEAR OVERLAND FLOWPATH  
ASBUILT PLAN  
SHEET 1 OF 4

ORIGINATOR:	DATE:	SIGNED:	PLOT BY:
GKW	04.2019		SXK
DRAWN:	DATE:	SIGNED:	PLOT DATE:
SXK	01.09.20		09.09.20
CHECKED:	DATE:	SIGNED:	SURVEY BY:
SXK	01.09.20		
APPROVED:	DATE:	SIGNED:	SURVEY DATE:
SXK	01.09.20		

ISSUE STATUS:

ASBUILT

PROJECT No:	1:500-A1	A1
1050-142875-01	1:1000-A3	
DRAWING No:		REV
142875-12-AB466		1

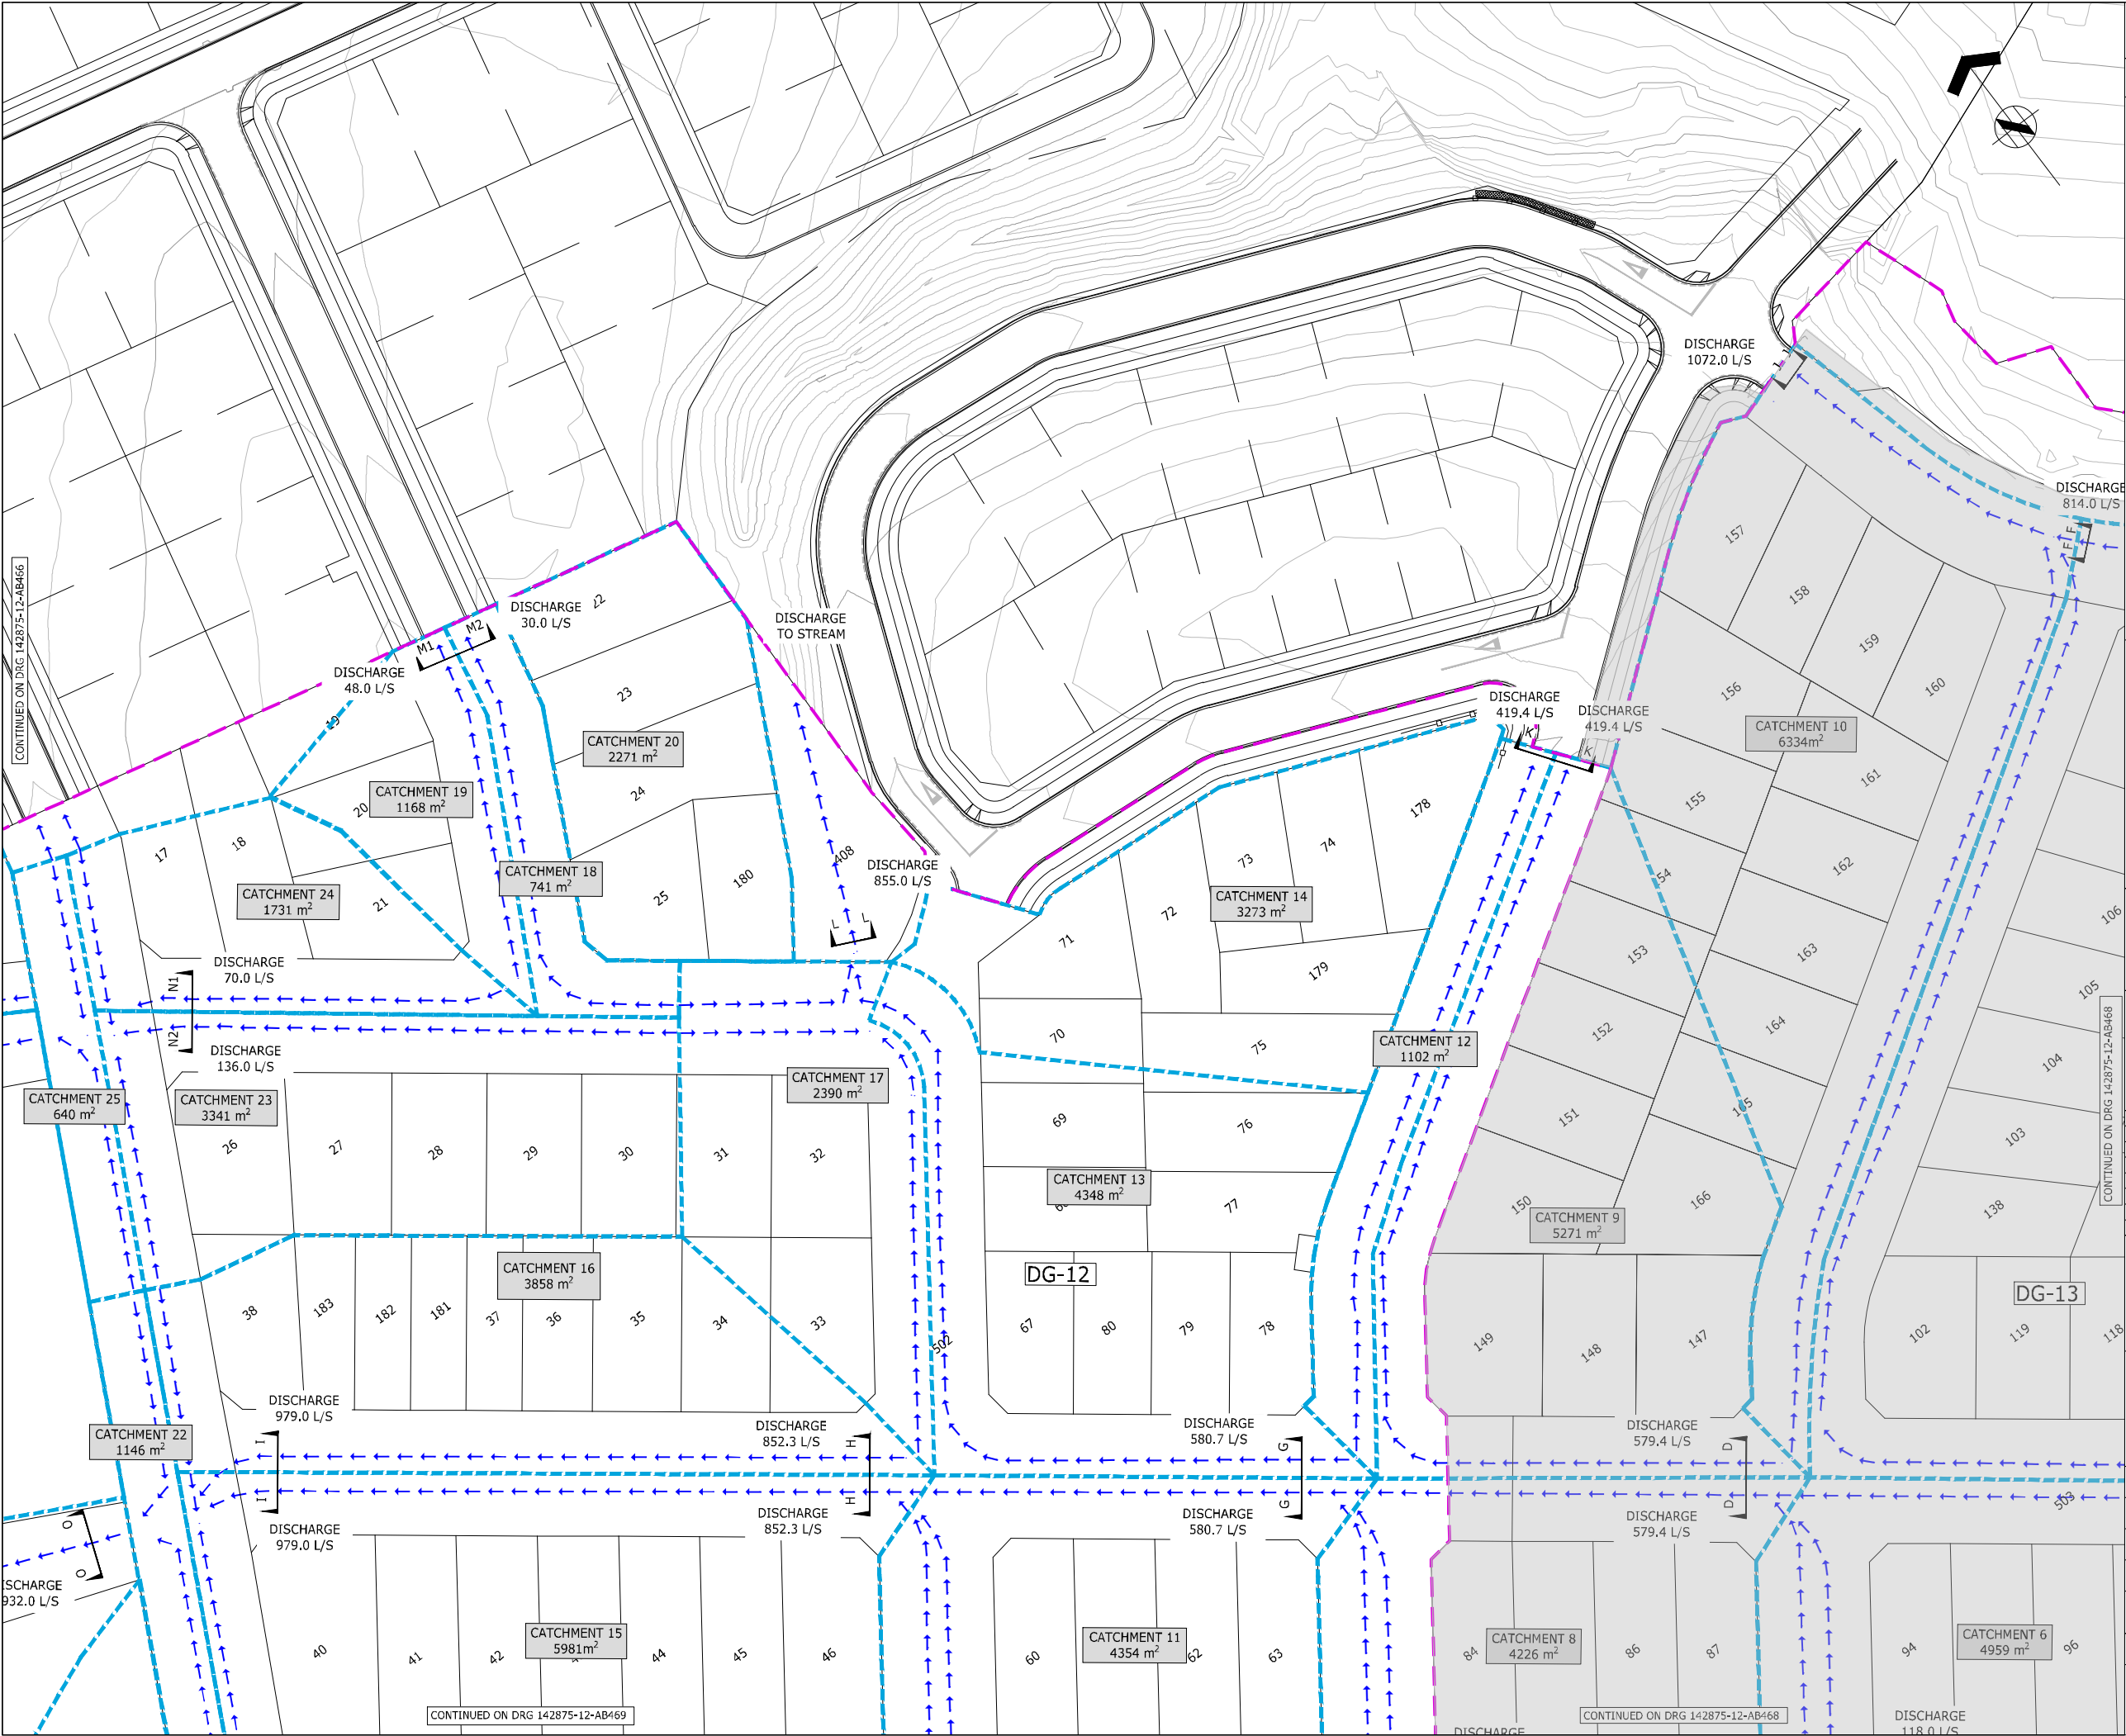

THIS DRAWING AND DESIGN REMAINS THE PROPERTY OF, AND MAY NOT BE REPRODUCED OR ALTERED, WITHOUT THE WRITTEN PERMISSION OF HARRISON GRIERSON CONSULTANTS LIMITED. NO LIABILITY SHALL BE ACCEPTED FOR UNAUTHORISED USE OF THIS DRAWING.

**NOTES**

1. REFER TO OVERLAND FLOW PATH ASBUILT CROSS SECTION DRAWINGS 142875-12-455 TO 457 FOR FLOWS AND VELOCITIES.


**LEGEND**

- CATCHMENT BOUNDARIES
- OVERLAND FLOWPATHS
- STAGE BOUNDARIES

**ENGINEERING APPROVAL**  
**EPA 60349136**

I CERTIFY THAT THESE ASBUILT PLANS ARE AN ACCURATE RECORD OF THE WORKS UNDERTAKEN AND THAT:

- THE COORDINATES (X,Y) ARE IN TERMS OF NZTM ON NZGD (2000), AND ARE WITHIN ±50mm.
- THE LEVELS (Z) ARE IN TERMS OF THE AUCKLAND 1946 (MSL) LINZ DATUM (DOSLI DATUM), AND ARE WITHIN ±10mm.

Signed:   
CHARTERED PROFESSIONAL ENGINEER

Date: ...08/09/2020.....

Name: SHANE KELLY

Phone: 09-917-5000

Email: s.kelly@harrisingrierson.com




**HUGH GREEN  
LIMITED**



AUCKLAND OFFICE  
LEVEL 4, 96 ST GEORGES BAY ROAD  
PARNELL AUCKLAND 1052  
T +64 9 917 5000  
W www.harrisingrierson.com

1	ASBUILT	SXK	01.09.20
REF	REVISIONS	BY	DATE
PROJECT:			
HUGH GREEN LIMITED DONEGAL STAGE 11D/12 36 TIR CONAILL AVENUE, FLAT BUSH			
TITLE: 100 YEAR OVERLAND FLOWPATH ASBUILT PLAN SHEET 2 OF 4			
ORIGINATOR: GKW	DATE: 04.2019	SIGNED:	PLOT BY: SXK
DRAWN: SXK	DATE: 01.09.20	SIGNED:	PLOT DATE: 09.09.20
CHECKED: SXK	DATE: 01.09.20	SIGNED:	SURVEY BY:
APPROVED: SXK	DATE: 01.09.20	SIGNED:	SURVEY DATE:
ISSUE STATUS: ASBUILT			
PROJECT No: 1050-142875-01	SCALES: 1:500-A1 1:1000-A3	A1	
DRAWING No:	142875-12-AB467		REV 1



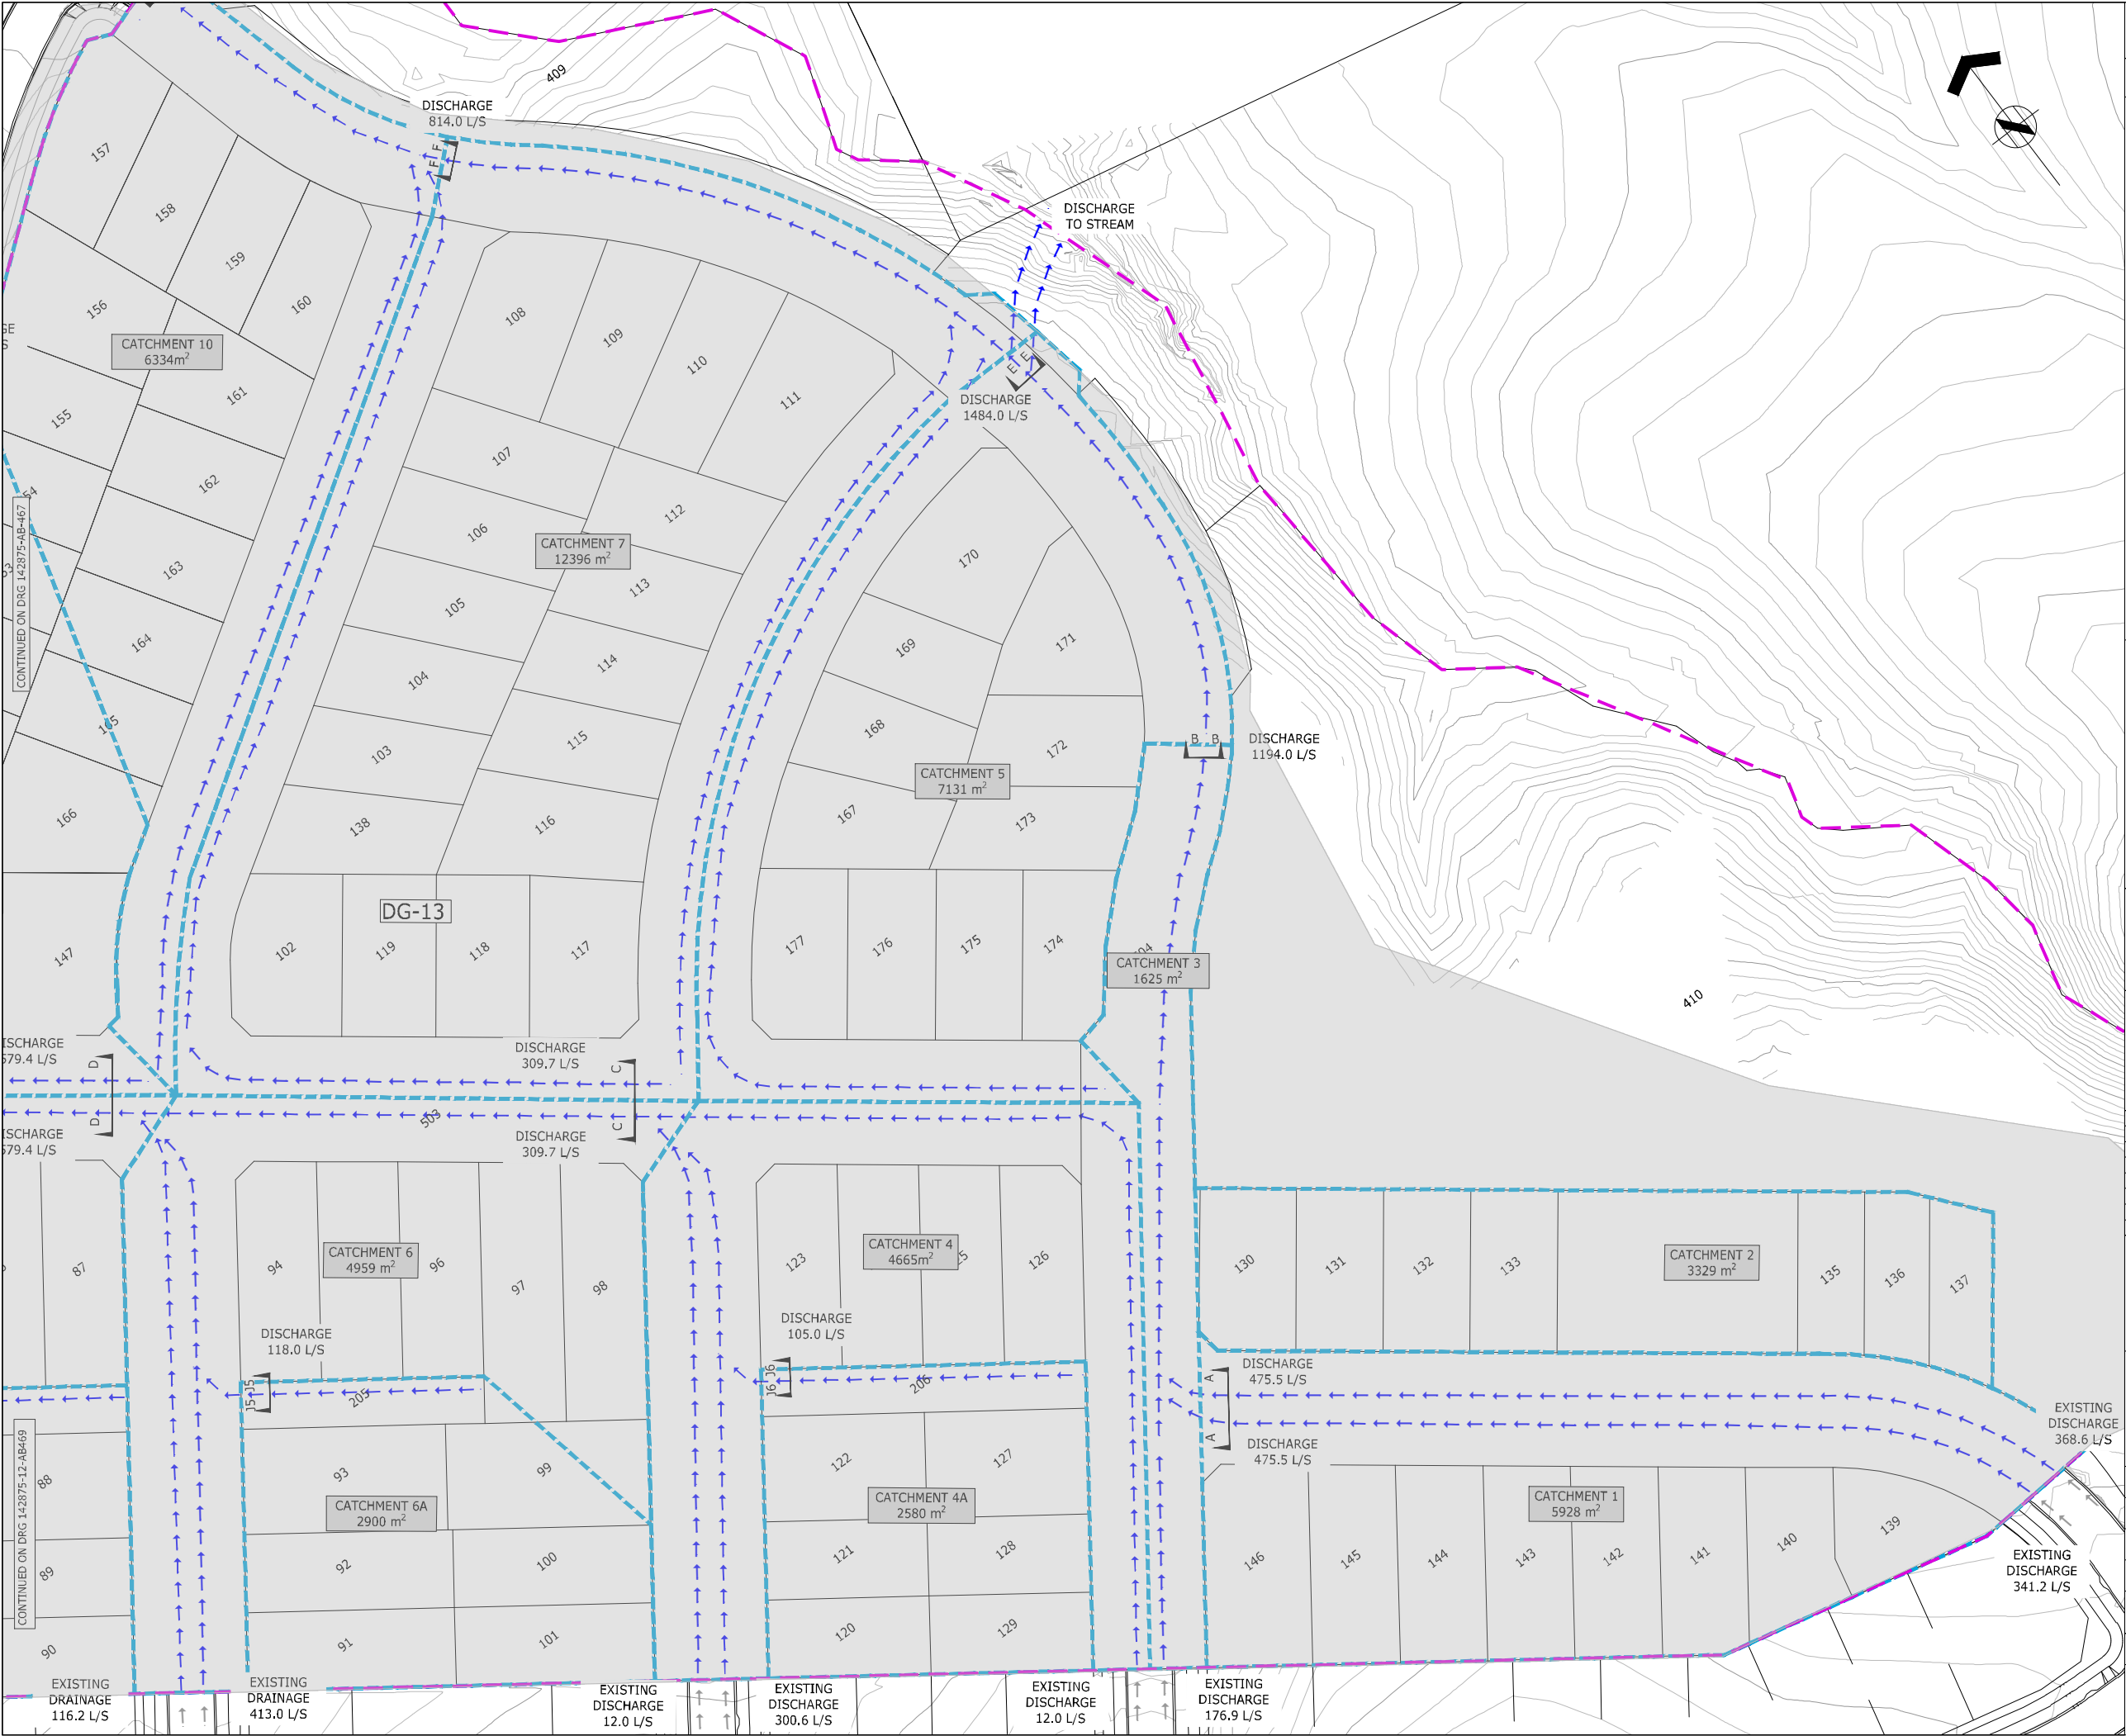

THIS DRAWING AND DESIGN REMAINS THE PROPERTY OF, AND MAY NOT BE REPRODUCED OR ALTERED, WITHOUT THE WRITTEN PERMISSION OF HARRISON GRIERSON CONSULTANTS LIMITED. NO LIABILITY SHALL BE ACCEPTED FOR UNAUTHORISED USE OF THIS DRAWING.

**NOTES**

1. REFER TO OVERLAND FLOW PATH ASBUILT CROSS SECTION DRAWINGS 142875-12-455 TO 457 FOR FLOWS AND VELOCITIES.

**LEGEND**

----- CATCHMENT BOUNDARIES


→ → → → OVERLAND FLOWPATHS

----- STAGE BOUNDARIES

**ENGINEERING APPROVAL**  
**EPA 60349136**

I CERTIFY THAT THESE ASBUILT PLANS ARE AN ACCURATE RECORD OF THE WORKS UNDERTAKEN AND THAT:

- THE COORDINATES (X,Y) ARE IN TERMS OF NZTM ON NZGD (2000), AND ARE WITHIN ±50mm.
- THE LEVELS (Z) ARE IN TERMS OF THE AUCKLAND 1946 (MSL) LINZ DATUM (DOSLI DATUM), AND ARE WITHIN ±10mm.

Signed:  CHARTERED PROFESSIONAL ENGINEER

Date: ..08/09/2020.....

Name: SHANE KELLY

Phone: 09-917-5000

Email: s.kelly@harrisongrierson.com

 **HUGH GREEN LIMITED**

**HG** AUCKLAND OFFICE  
LEVEL 4, 96 ST GEORGES BAY ROAD  
PARNELL AUCKLAND 1052  
T +64 9 917 5000  
W www.harrisongrierson.com

1	ASBUILT	SXK	01.09.20
REF	REVISIONS	BY	DATE
PROJECT:			

**HUGH GREEN LIMITED**  
**DONEGAL STAGE 11D/12**  
**36 TIR CONAILL AVENUE, FLAT BUSH**

**TITLE:**

**100 YEAR OVERLAND FLOWPATH**  
**ASBUILT PLAN**  
**SHEET 3 OF 4**


ORIGINATOR:	DATE:	SIGNED:	PLOT BY:
GKW	04.2019		SXK
DRAWN:	DATE:	SIGNED:	PLOT DATE:
SXK	01.09.20		09.09.20
CHECKED:	DATE:	SIGNED:	SURVEY BY:
SXK	01.09.20		
APPROVED:	DATE:	SIGNED:	SURVEY DATE:
SXK	01.09.20		

ISSUE STATUS: **ASBUILT**

PROJECT No:	SCALES:	A1
1050-142875-01	1:500-A1 1:1000-A3	
DRAWING No:		REV

**142875-12-AB468**

**1**

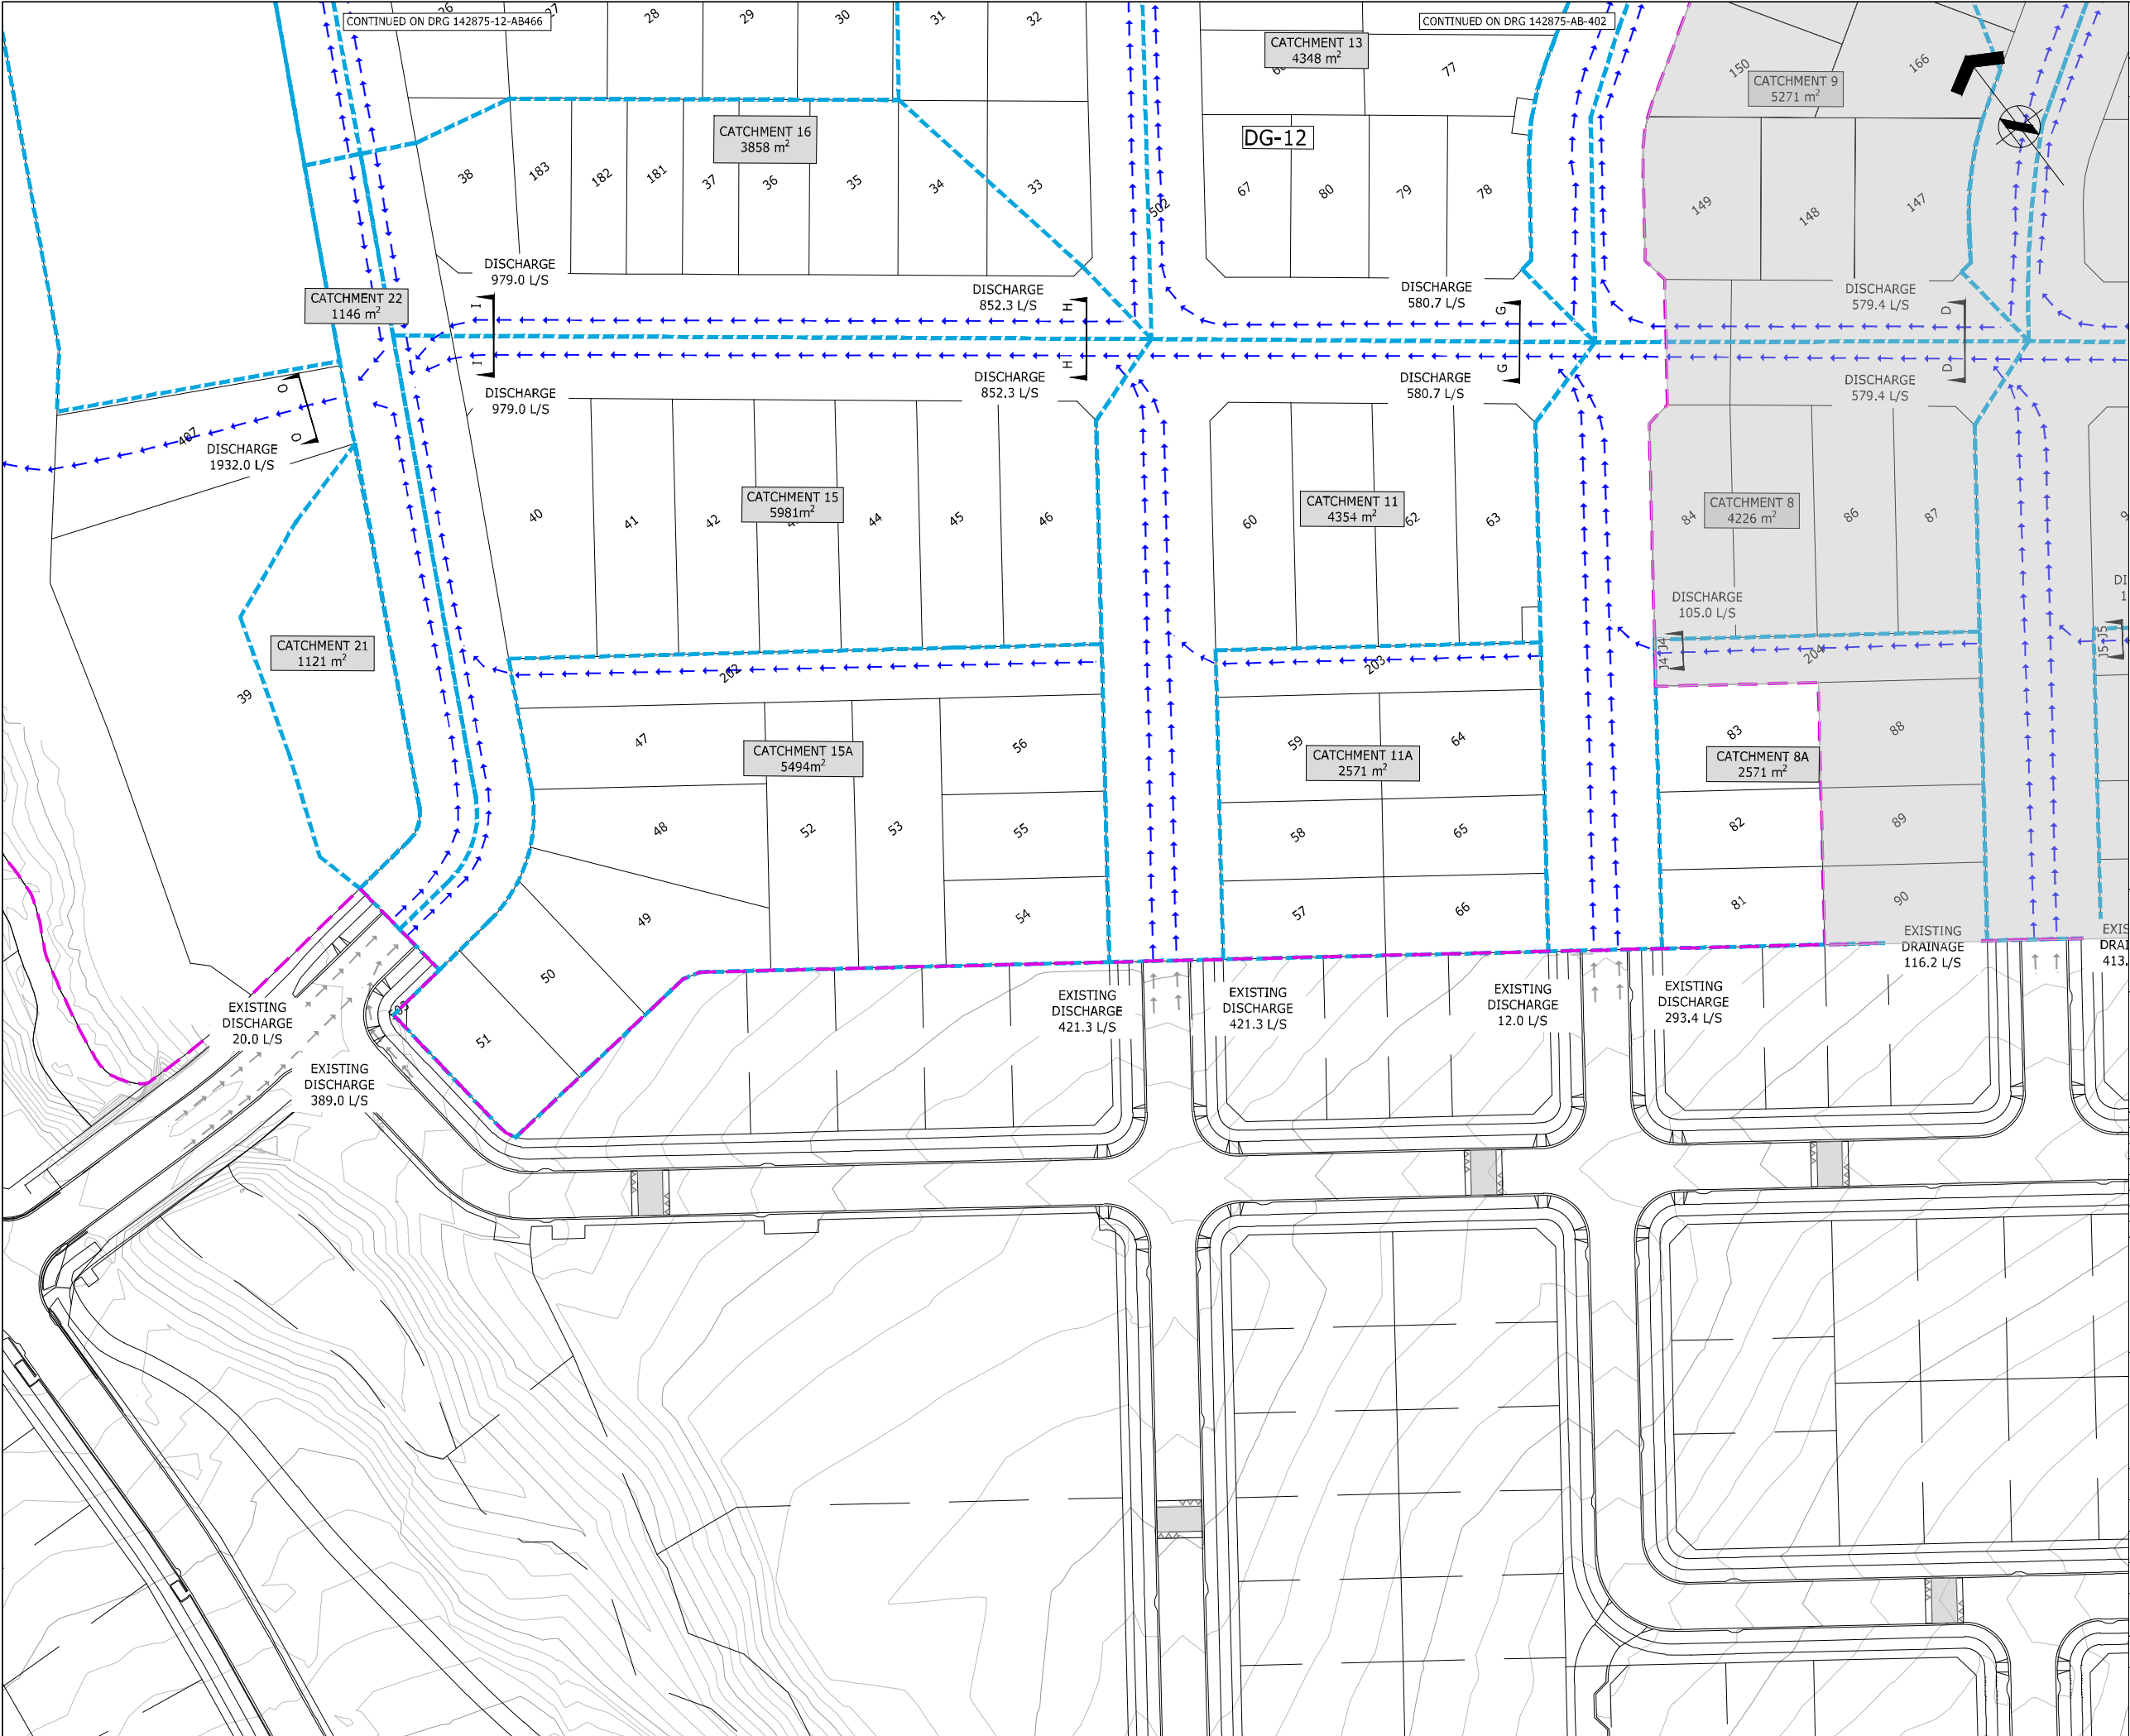



ASSOCIATION OF CONSULTING  
ENGINEERS NEW ZEALAND

ISO 9001  
QUALITY  
ASSURED

THIS DRAWING AND DESIGN REMAINS THE PROPERTY OF, AND MAY NOT BE REPRODUCED OR ALTERED, WITHOUT THE WRITTEN PERMISSION OF HARRISON GRIERSON CONSULTANTS LIMITED. NO LIABILITY SHALL BE ACCEPTED FOR UNAUTHORISED USE OF THIS DRAWING.

### NOTES

1. REFER TO OVERLAND FLOW PATH ASBUILT CROSS SECTION DRAWINGS 142875-12-455 TO 457 FOR FLOWS AND VELOCITIES.

### LEGEND

CATCHMENT BOUNDARIES

OVERLAND FLOWPATHS

STAGE BOUNDARIES

ENGINEERING APPROVAL  
EPA 60349136

I CERTIFY THAT THESE ASBUILT PLANS ARE AN ACCURATE RECORD OF THE WORKS UNDERTAKEN AND THAT:

- THE COORDINATES (X,Y) ARE IN TERMS OF NZTM ON NZGD (2000), AND ARE WITHIN ±50mm.
- THE LEVELS (Z) ARE IN TERMS OF THE AUCKLAND 1946 (MSL) LINZ DATUM (DOSLI DATUM), AND ARE WITHIN ±10mm.

Signed:   
CHARTERED PROFESSIONAL ENGINEER

Date: ...08/09/2020.....

Name: SHANE KELLY

Phone: 09-917-5000

Email: s.kelly@harrsongrierson.com



HUGH GREEN  
GROUP

HUGH GREEN  
LIMITED




AUCKLAND OFFICE  
LEVEL 4, 96 ST GEORGES BAY ROAD  
PARNELL AUCKLAND 1052  
T +64 9 917 5000  
W www.harrsongrierson.com

1	ASBUILT	SXK	01.09.20
REF	REVISIONS	BY	DATE
PROJECT:			
HUGH GREEN LIMITED DONEGAL STAGE 11D/12 36 TIR CONAILL AVENUE, FLAT BUSH			
TITLE:			
100 YEAR OVERLAND FLOWPATH ASBUILT PLAN SHEET 4 OF 4			
ORIGINATOR:	DATE:	SIGNED:	PLOT BY:
GKW	04.2019		SXK
DRAWN:	DATE:	SIGNED:	PLOT DATE:
SXK	01.09.20		09.09.20
CHECKED:	DATE:	SIGNED:	SURVEY BY:
SXK	01.09.20		
APPROVED:	DATE:	SIGNED:	SURVEY DATE:
SXK	01.09.20		
ISSUE STATUS:			
ASBUILT			
PROJECT No:	SCALES:	A1	
1050-142875-01	1:500-A1 1:1000-A3		
DRAWING No:			REV
142875-12-AB469			1

## **APPENDIX 2**

# **OVERLAND FLOW ASBUILT CROSS SECTIONS**

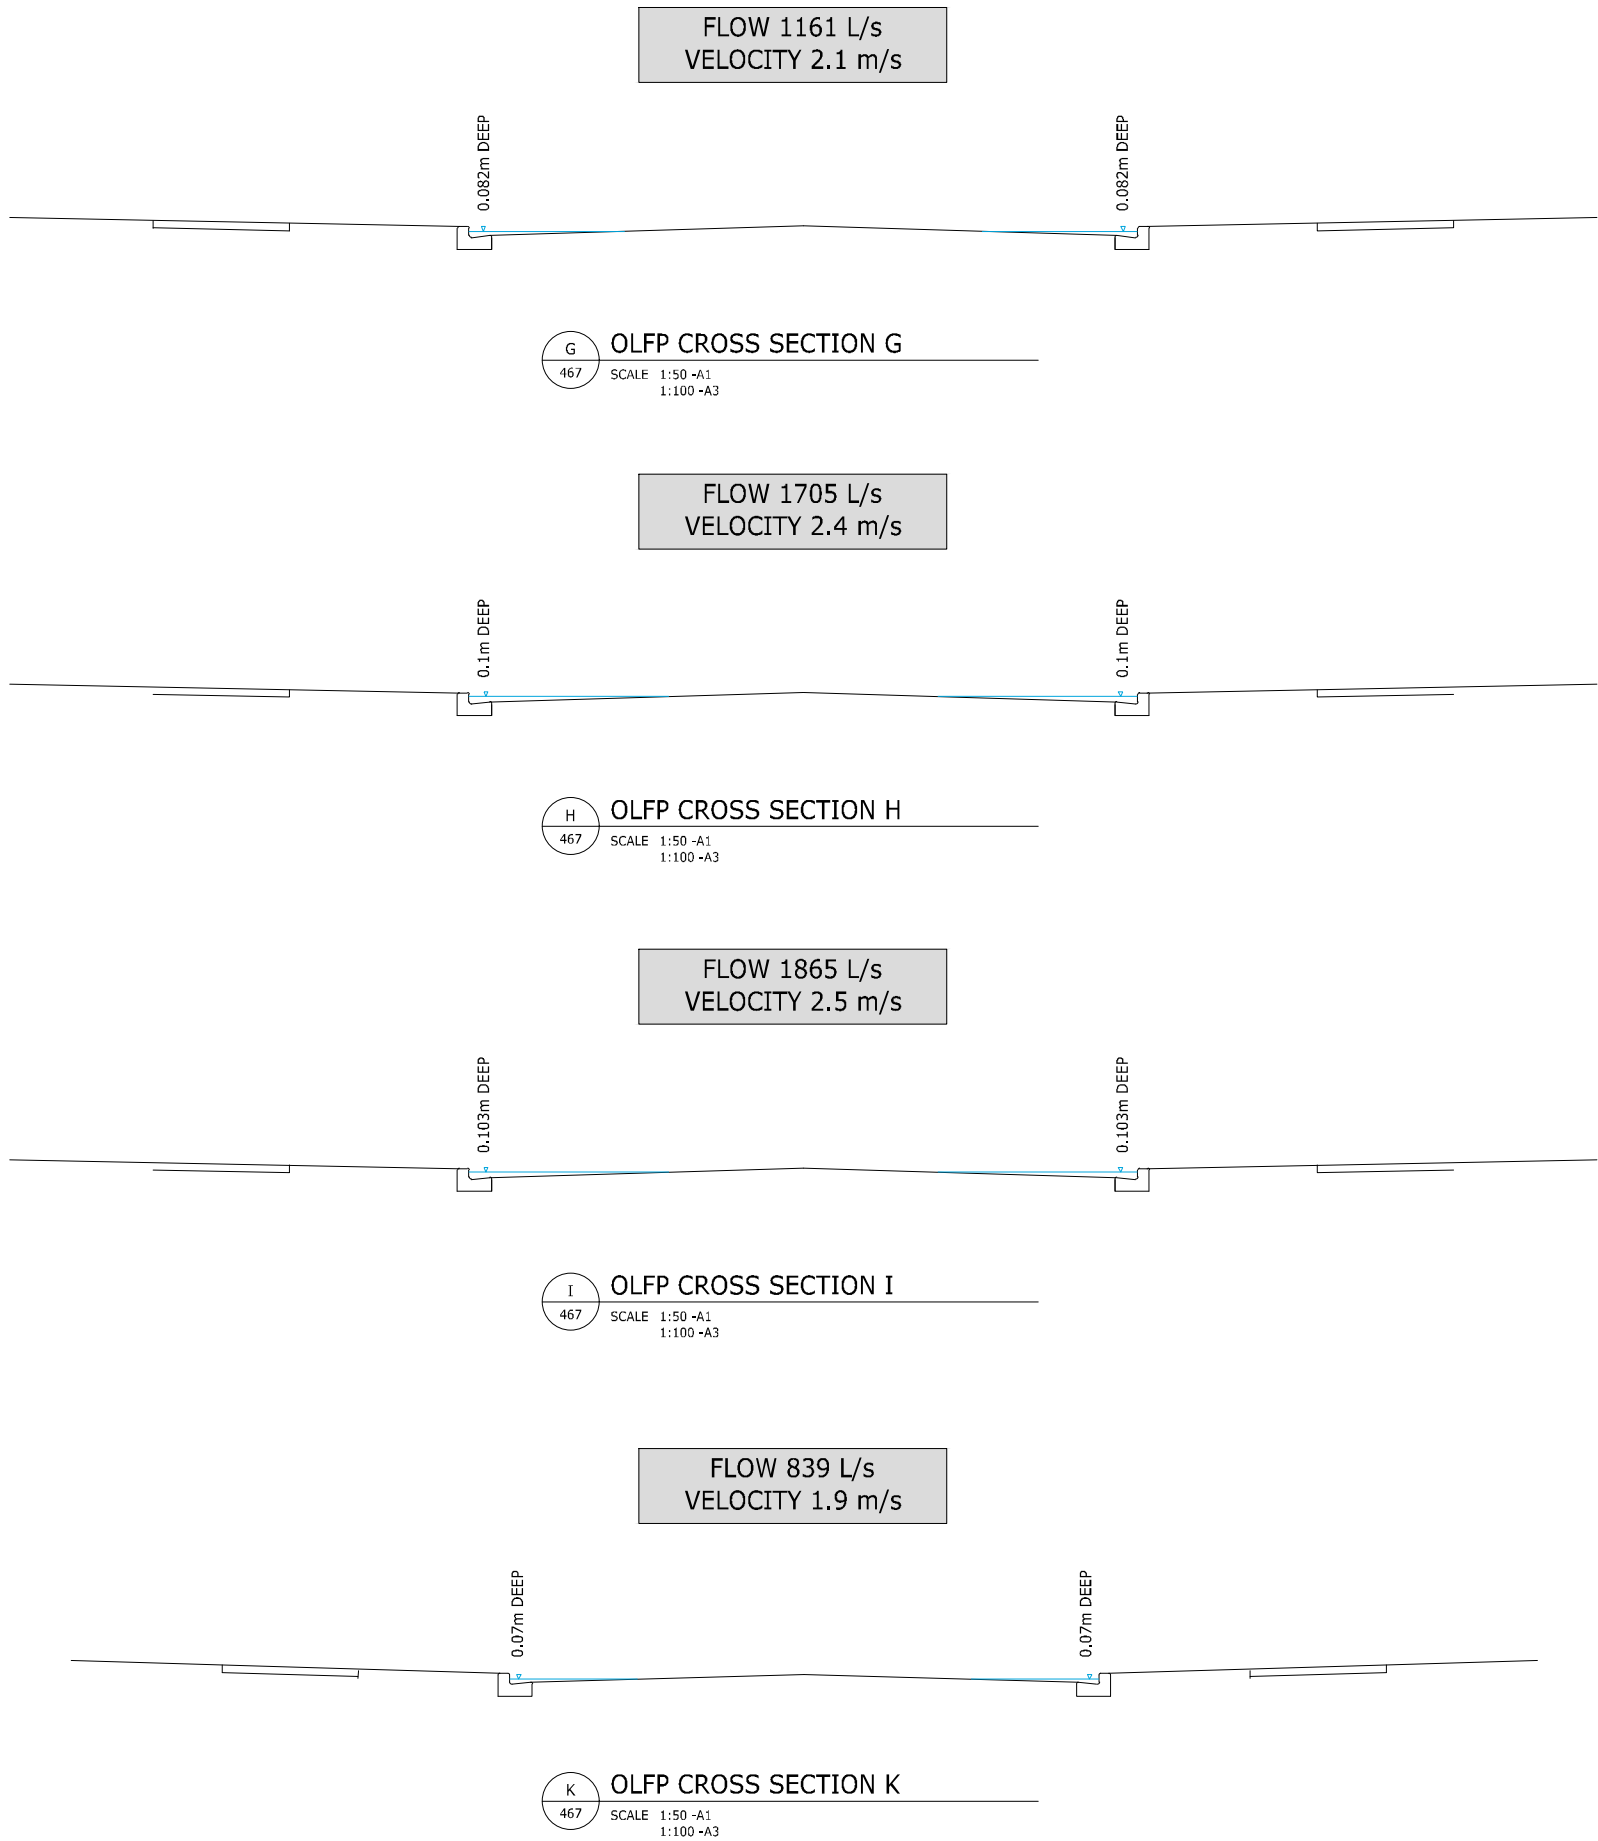

THIS DRAWING AND DESIGN REMAINS THE PROPERTY OF, AND MAY NOT BE REPRODUCED OR ALTERED, WITHOUT THE WRITTEN PERMISSION OF HARRISON GRIERSON CONSULTANTS LIMITED. NO LIABILITY SHALL BE ACCEPTED FOR UNAUTHORISED USE OF THIS DRAWING.

NOTES:

- LEVELS ARE IN TERMS OF AUCKLAND VERTICAL DATUM 1946  
ORIGIN OF LEVELS  
SS 66 50 48643  
RL 54.50
- CATCHMENT AREAS AND DISCHARGE FLOWS INCORPORATE FUTURE OVERLAND FLOWPATH GENERATION FROM UPSTREAM DEVELOPMENT.
- ALL FLOWPATHS ARE WITHIN THE LEGAL ROAD WIDTH.

LEGEND

OVERLAND FLOWPATH  
LEVEL IN 1% AEP  
STORM EVENT

ENGINEERING APPROVAL  
EPA 60349136

I CERTIFY THAT THESE ASBUILT PLANS ARE AN ACCURATE RECORD OF THE WORKS UNDERTAKEN AND THAT:  
• THE COORDINATES (X,Y) ARE IN TERMS OF NZTM ON NZGD (2000), AND ARE WITHIN ±50mm.  
• THE LEVELS (Z) ARE IN TERMS OF THE AUCKLAND 1946 (MSL) LINZ DATUM (DOSLI DATUM), AND ARE WITHIN ±10mm.

Signed: [Signature]  
CHARTERED PROFESSIONAL ENGINEER

Date: ...08/09/2020.....

Name: SHANE KELLY

Phone: 09-917-5000

Email: s.kelly@harrisingrierson.com



HUGH GREEN  
LIMITED



AUCKLAND OFFICE  
LEVEL 4, 96 ST GEORGES BAY ROAD  
PARNELL AUCKLAND 1052  
T +64 9 917 5000  
W www.harrisingrierson.com

1	ASBUILT	SXK	08.09.20
REF	REVISIONS	BY	DATE

PROJECT:  
HUGH GREEN LIMITED  
DONEGAL 11D/12  
36 TIR CONAILL AVENUE, FLAT BUSH

TITLE:  
OVERLAND FLOW PATH  
ASBUILT CROSS SECTIONS  
1 OF 3

ORIGINATOR: GKW	DATE: 04.2019	SIGNED:	PLOT BY: SXK
DRAWN: SXK	DATE: 08.09.20	SIGNED:	PLOT DATE: 09.09.20
CHECKED: SXK	DATE: 08.09.20	SIGNED:	SURVEY BY: DW
APPROVED: SXK	DATE: 08.09.20	SIGNED:	SURVEY DATE: 01.08.20

ISSUE STATUS:  
ASBUILT

PROJECT No: 1050-142875-01	SCALES: AS SHOWN	A1
DRAWING No:		REV
142875-12-AB455		1



NOTES:

- LEVELS ARE IN TERMS OF AUCKLAND VERTICAL DATUM 1946  
  
ORIGIN OF LEVELS  
SS 66 50 48643  
RL 54.50
- CATCHMENT AREAS AND DISCHARGE FLOWS INCORPORATE FUTURE OVERLAND FLOWPATH GENERATION FROM UPSTREAM DEVELOPMENT.
- ALL FLOWPATHS ARE WITHIN THE LEGAL ROAD WIDTH.

LEGEND

 OVERLAND FLOWPATH  
LEVEL IN 1% AEP  
STORM EVENT

ENGINEERING APPROVAL  
EPA 60349136

I CERTIFY THAT THESE ASBUILT PLANS ARE AN ACCURATE RECORD OF THE WORKS UNDERTAKEN AND THAT:

- THE COORDINATES (X,Y) ARE IN TERMS OF NZTM ON NZGD (2000), AND ARE WITHIN ±50mm.
- THE LEVELS (Z) ARE IN TERMS OF THE AUCKLAND 1946 (MSL) LINZ DATUM (DOSLI DATUM), AND ARE WITHIN ±10mm.

Signed:   
CHARTERED PROFESSIONAL ENGINEER

Date: ...08/09/2020.....

Name: SHANE KELLY

Phone: 09-917-5000

Email: s.kelly@harrisongrierson.com



HUGH GREEN  
LIMITED



AUCKLAND OFFICE  
LEVEL 4, 96 ST GEORGES BAY ROAD  
PARNELL AUCKLAND 1052  
T +64 9 917 5000  
W www.harrisongrierson.com

1	ASBUILT	SXK	08.09.20
REF	REVISIONS	BY	DATE

PROJECT:

HUGH GREEN LIMITED  
DONEGAL 11D/12  
36 TIR CONAILL AVENUE, FLAT BUSH

TITLE:


OVERLAND FLOW PATH  
ASBUILT CROSS SECTIONS  
2 OF 3


ORIGINATOR: GKW	DATE: 04.2019	SIGNED:	PLOT BY: SXK
DRAWN: SXK	DATE: 08.09.20	SIGNED:	PLOT DATE: 09.09.20
CHECKED: SXK	DATE: 08.09.20	SIGNED:	SURVEY BY: DW
APPROVED: SXK	DATE: 08.09.20	SIGNED:	SURVEY DATE: 01.08.20

ISSUE STATUS:


ASBUILT

PROJECT No: 1050-142875-01	SCALES: AS SHOWN	A1
DRAWING No:		REV
142875-12-AB456		1

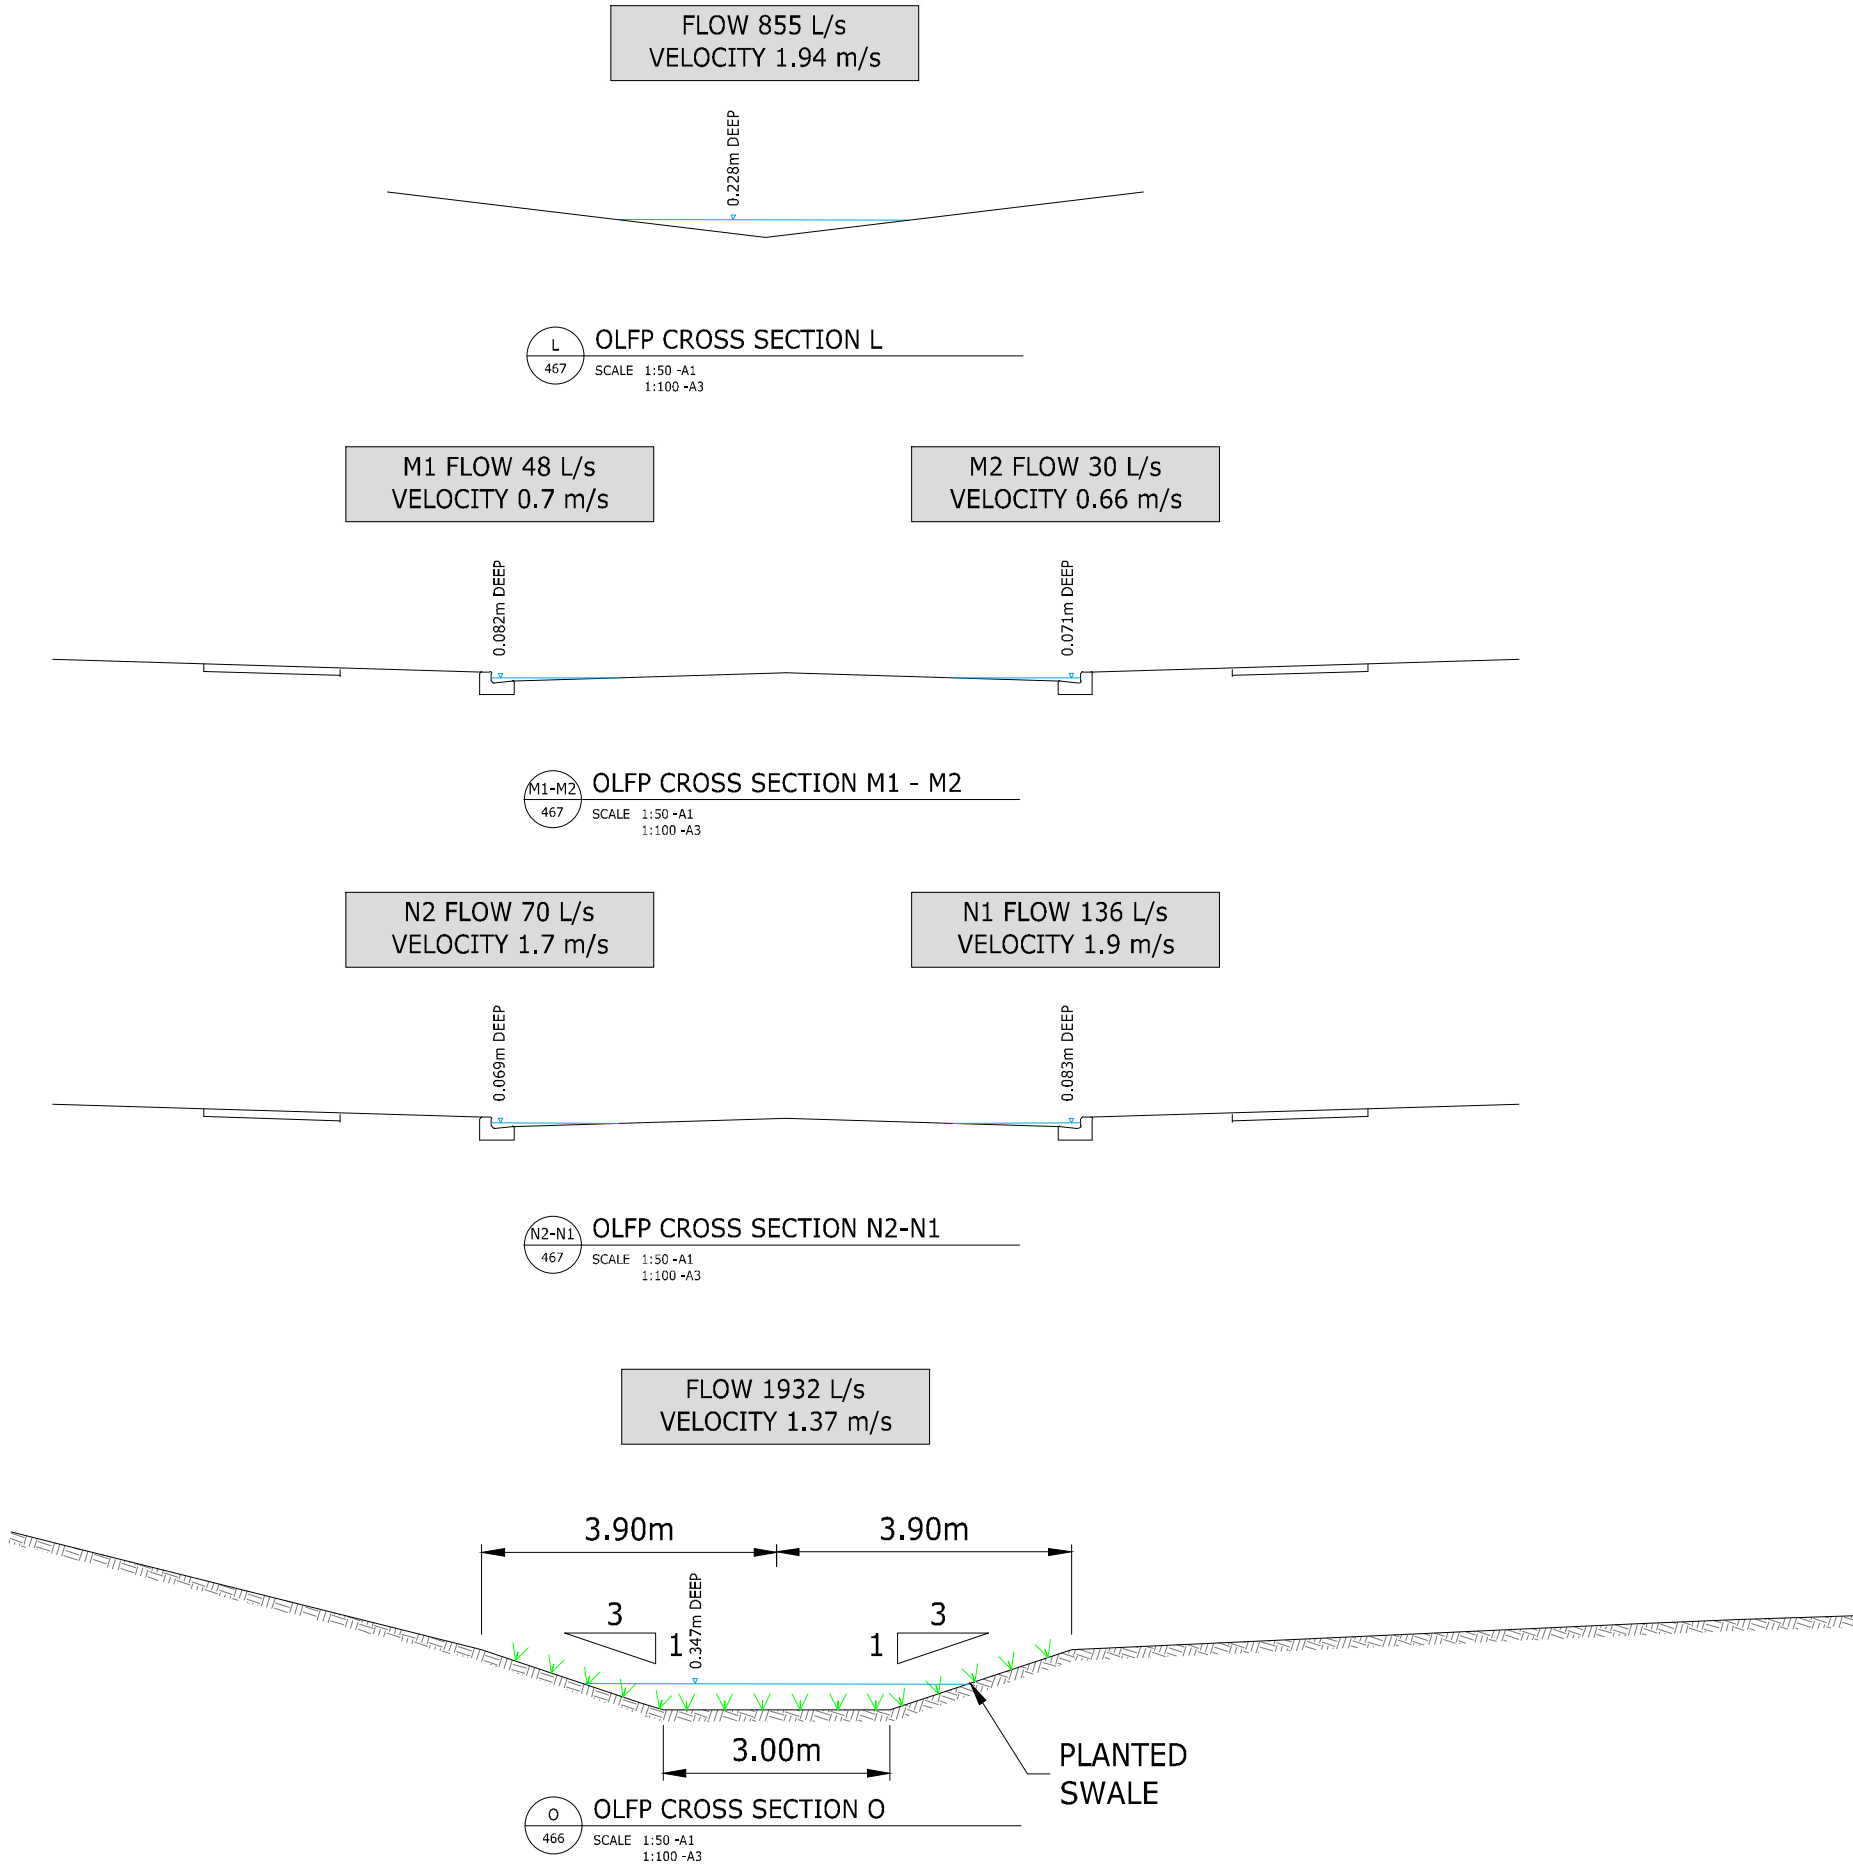

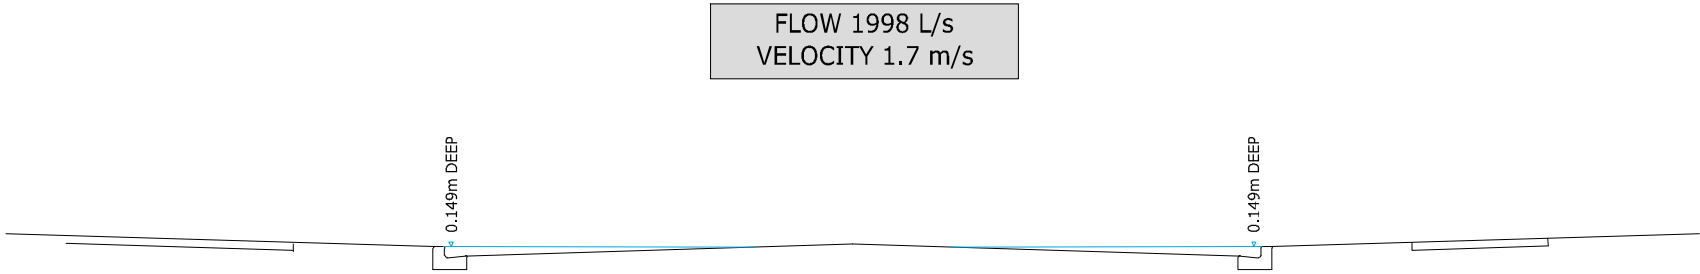


P  
466  
SCALE 1:50 -A1  
1:100 -A3  
OLFP CROSS SECTION P

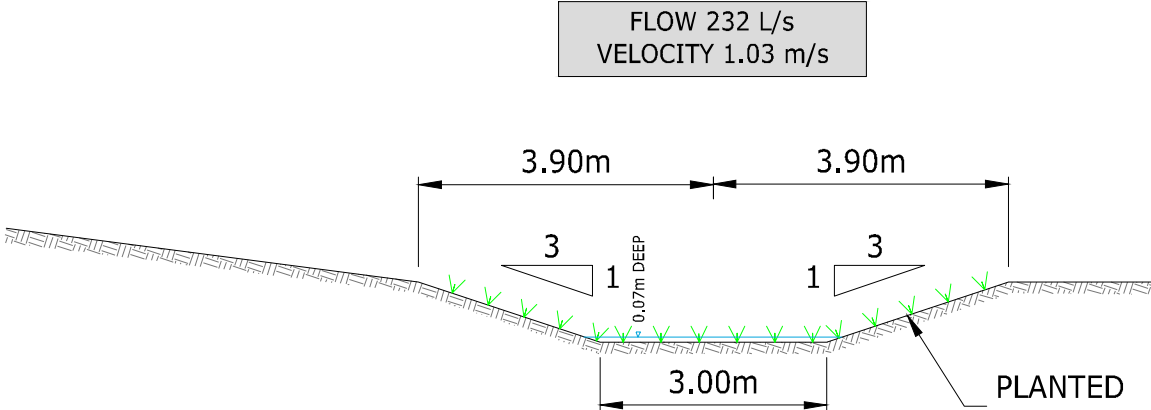

Q  
466  
SCALE 1:50 -A1  
1:100 -A3  
OLFP CROSS SECTION Q

FLOW 170 L/s  
VELOCITY 1.6 m/s

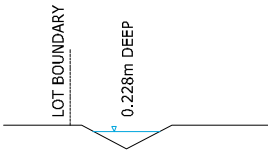

R  
466  
SCALE 1:50 -A1  
1:100 -A3  
OLFP CROSS SECTION R

THIS DRAWING AND DESIGN REMAINS THE PROPERTY OF, AND MAY NOT BE REPRODUCED OR ALTERED, WITHOUT THE WRITTEN PERMISSION OF HARRISON GRIERSON CONSULTANTS LIMITED. NO LIABILITY SHALL BE ACCEPTED FOR UNAUTHORISED USE OF THIS DRAWING.

- NOTES:**
- LEVELS ARE IN TERMS OF AUCKLAND VERTICAL DATUM 1946  
  
ORIGIN OF LEVELS  
SS 66 SO 48643  
RL 54.50
  - CATCHMENT AREAS AND DISCHARGE FLOWS INCORPORATE FUTURE OVERLAND FLOWPATH GENERATION FROM UPSTREAM DEVELOPMENT.
  - ALL FLOWPATHS ARE WITHIN THE LEGAL ROAD WIDTH.


**LEGEND**

 OVERLAND FLOWPATH  
LEVEL IN 1% AEP  
STORM EVENT

**ENGINEERING APPROVAL**  
EPA 60349136

I CERTIFY THAT THESE ASBUILT PLANS ARE AN ACCURATE RECORD OF THE WORKS UNDERTAKEN AND THAT:

- THE COORDINATES (X,Y) ARE IN TERMS OF NZTM ON NZGD (2000), AND ARE WITHIN ±50mm.
- THE LEVELS (Z) ARE IN TERMS OF THE AUCKLAND 1946 (MSL) LINZ DATUM (DOSLI DATUM), AND ARE WITHIN ±10mm.

Signed:   
CHARTERED PROFESSIONAL ENGINEER

Date: ...08/09/2020.....

Name: SHANE KELLY

Phone: 09-917-5000

Email: s.kelly@harrisongrierson.com

 HUGH GREEN  
GROUP

HUGH GREEN  
LIMITED



AUCKLAND OFFICE  
LEVEL 4, 96 ST GEORGES BAY ROAD  
PARNELL AUCKLAND 1052  
T +64 9 917 5000  
W www.harrisongrierson.com

1	ASBUILT	SXK	08.09.20
REF	REVISIONS	BY	DATE

PROJECT:

HUGH GREEN LIMITED  
DONEGAL 11D/12  
36 TIR CONAILL AVENUE, FLAT BUSH

TITLE:

OVERLAND FLOW PATH  
ASBUILT CROSS SECTIONS  
3 OF 3

ORIGINATOR:	DATE:	SIGNED:	PLOT BY:
GKW	04.2019		SXK
DRAWN:	DATE:	SIGNED:	PLOT DATE:
SXK	08.09.20		09.09.20
CHECKED:	DATE:	SIGNED:	SURVEY BY:
SXK	08.09.20		DW
APPROVED:	DATE:	SIGNED:	SURVEY DATE:
SXK	08.09.20		01.08.20

ISSUE STATUS:			ASBUILT
PROJECT No:	SCALES:	AS SHOWN	A1
DRAWING No:			REV
142875-12-AB457			1

## **APPENDIX 3**

# **OVERLAND FLOW CALCULATIONS**

### 36 Tir Conaill Ave - Donegal

HG PROJECT NUMBER:

1050-142875-01

DATE:

1/09/2020



Runoff Coefficient - C	0.8	
Rainfall Intensity (100year) - I	183	mm/hour
Catchment Area	12.69	ha

$$Q = CIA \times 2.78/1000$$

CATCHMENT	AREA (ha)
1	0.5928
2	0.3329
3	0.1625
4	0.4665
4A (JOAL 6)	0.258
5	0.7131
6	0.4959
6A (JOAL 5)	0.29
7	1.2396
8	0.4226
8A (JOAL 4)	0.257
9	0.5271
10	0.6334
11	0.4354
11A (JOAL 3)	0.2571
12	0.1102
13	0.4348
14	0.2319
15	0.5981
15A (JOAL 1)	0.5494
16	0.3858
17	0.239
18	0.0741
19	0.1168
20	0.2271
21	0.1121
22	0.1146
23	0.3341
24	0.1731

CROSS SECTION	CATCHMENT	AREA (Ha)	Q (m³/s)	EXISTING DISCHARGE	CUMALATIVE FLOW
A	1	0.593	0.241	0.710	0.951
B	1+3	0.163	0.066	0.177	1.194
C	4+4A	0.725	0.295	0.325	0.619
D	4+4A+6+6A	0.786	0.320	0.529	1.159
E	1+3+5	0.713	0.290		1.484
F	7	1.240	0.505	0.310	0.814
G	4+4A+6+6A+8+8A	0.680	0.277	0.305	1.161
H	4+4A+6+6A+8+8A+11+11A	0.693	0.282	0.842	1.705
I	4+4A+6+6A+8+8A+11+11A +15+15A+16	1.533	0.624	0.389	1.865
J	7+10	0.633	0.258		1.072
K	9+12	0.637	0.259		0.839
L	13+17	0.674	0.274		0.855
M1	19	0.117	0.048		0.048
M2	18	0.074	0.030		0.030
N1	24	0.173	0.070		0.070
N2	23	0.334	0.136		0.136
O	4+4A+6+6A+8+8A+11+11A +15+15A+16+22	0.115	0.047	0.020	1.932
P	28+29+30	0.458	0.186	1.812	1.998
Q	24+23+25	0.064	0.026		0.232
R	26	0.418	0.170		0.170

Notes:

Includes only 1/2 of XS C-C  
Discharge Point  
Includes only 1/2 of XS D-D  
Includes only 1/2 of XS G-G

Includes 1/2 of XS D-D  
Includes 1/2 of XS G-G

Discharge Point

Discharge Point

JOAL CROSS SECTIONS					
J1	15A	0.549	0.224		0.224
J2	30	0.290	0.118		0.118
J3	11A	0.257	0.105		0.105
J4	8A	0.257	0.105		0.105
J5	6A	0.290	0.118		0.118
J6	4A	0.258	0.105		0.105

25	0.064
26	0.4182
27	0.8366
28	0.0859
29	0.0822
30 (JOAL 2)	0.2895
31	0.1257


\*OLF Path & Catchment plans refer to drawings:

142875-12-AB465  
142875-12-AB466  
142875-12-AB467  
142875-12-AB468  
142875-12-AB469

## **APPENDIX 4**



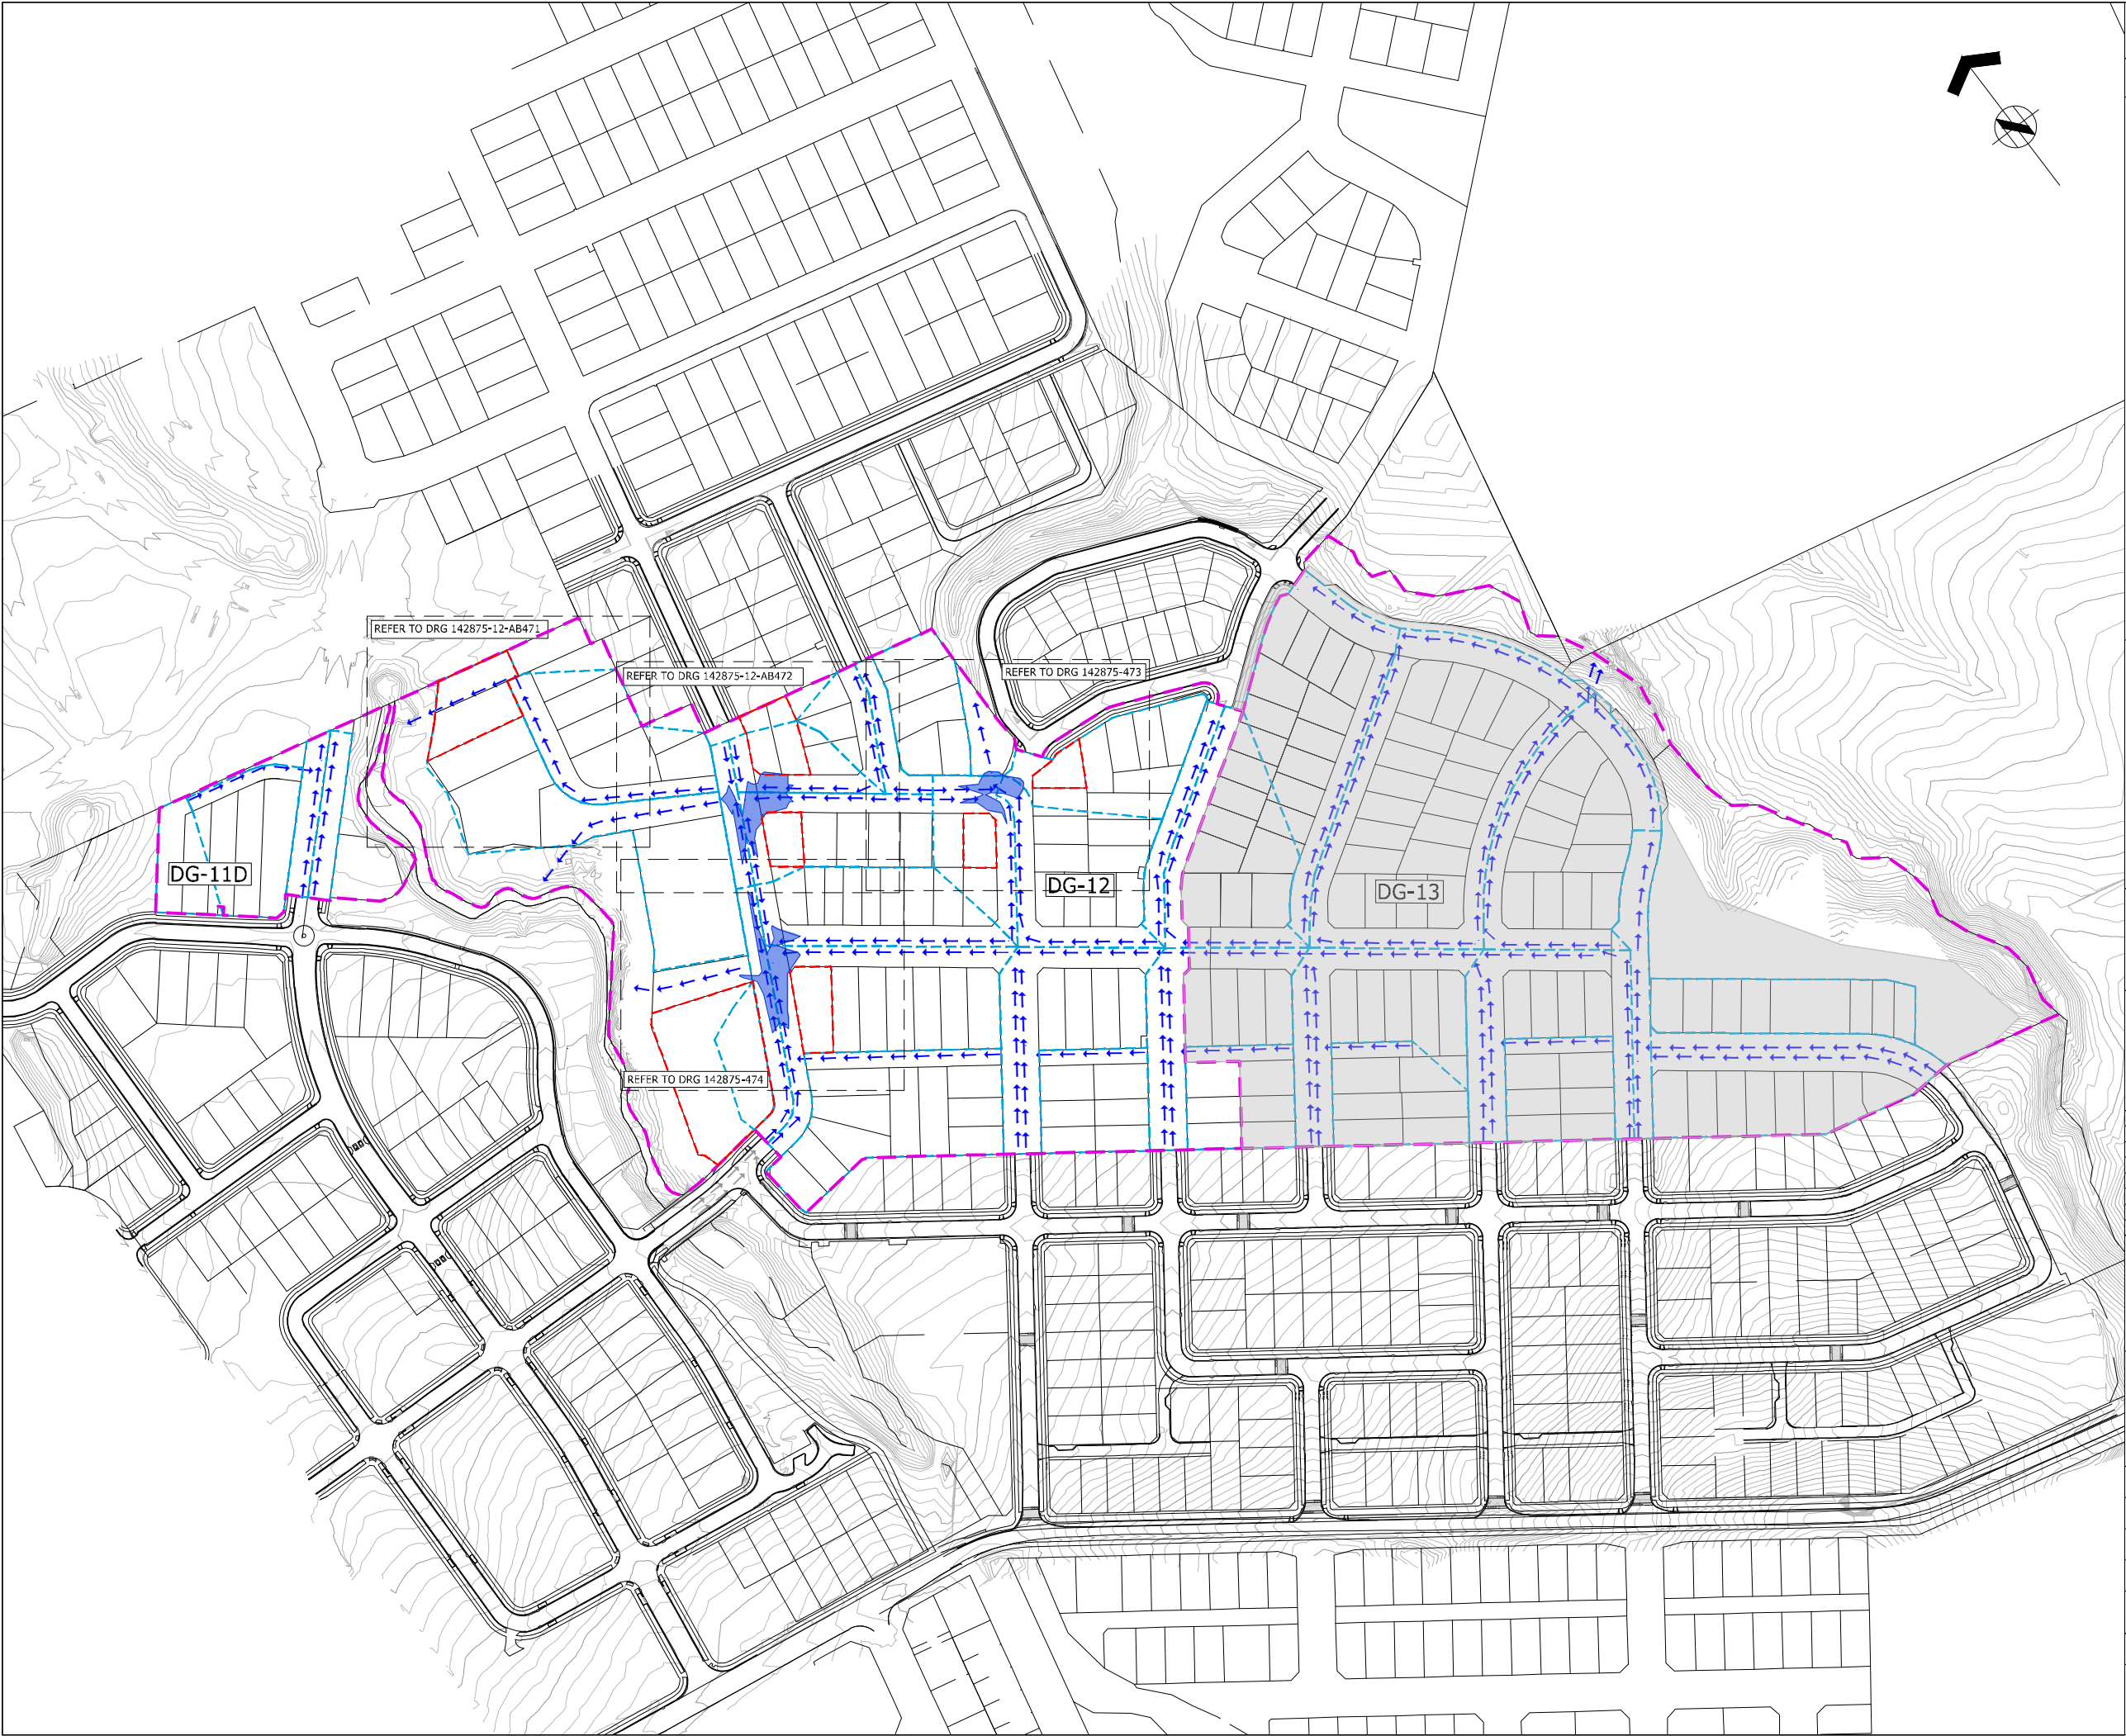

# **MINIMUM FLOOR LEVEL ASBUILT PLANS**





THIS DRAWING AND DESIGN REMAINS THE PROPERTY OF, AND MAY NOT BE REPRODUCED OR ALTERED, WITHOUT THE WRITTEN PERMISSION OF HARRISON GRIERSON CONSULTANTS LIMITED. NO LIABILITY SHALL BE ACCEPTED FOR UNAUTHORISED USE OF THIS DRAWING.


- NOTES:**
- LEVELS ARE IN TERMS OF AUCKLAND VERTICAL DATUM 1946  
  
ORIGIN OF LEVELS  
SS 66 SO 48643  
RL 54.50
  - COORDINATES ARE IN TERMS OF NZTM.
  - CATCHMENT AREAS AND DISCHARGE FLOWS INCORPORATE FUTURE OVERLAND FLOWPATH GENERATION FROM UPSTREAM DEVELOPMENT.

- LEGEND**
-  EXTENT OF 1% AEP (24 HR) FOOD BEFORE OVERTOPPING KERB
  -  PRIVATE LOTS WITH MINIMUM FLOOR LEVEL REQUIREMENTS
  -  CATCHMENT BOUNDARIES
  -  OVERLAND FLOWPATHS

ENGINEERING APPROVAL  
EPA 60349136

I CERTIFY THAT THESE ASBUILT PLANS ARE AN ACCURATE RECORD OF THE WORKS UNDERTAKEN AND THAT:

- THE COORDINATES (X,Y) ARE IN TERMS OF NZTM ON NZGD (2000), AND ARE WITHIN ±50mm.
- THE LEVELS (Z) ARE IN TERMS OF THE AUCKLAND 1946 (MSL) LINZ DATUM (DOSLI DATUM), AND ARE WITHIN ±10mm.

Signed:  .....  
CHARTERED PROFESSIONAL ENGINEER

Date: ..08/09/2020.....

Name: SHANE KELLY

Phone: 09-917-5000

Email: s.kelly@harrisingrierson.com

 HUGH GREEN  
GROUP

HUGH GREEN  
LIMITED

 AUCKLAND OFFICE  
LEVEL 4, 96 ST GEORGES BAY ROAD  
PARNELL AUCKLAND 1052  
T +64 9 917 5000  
W www.harrisingrierson.com


1	ASBUILT	SXK	01.09.20
REF	REVISIONS	BY	DATE
PROJECT:			

HUGH GREEN LIMITED  
DONEGAL STAGE 11D/12  
36 TIR CONAILL AVENUE, FLAT BUSH

TITLE:

MINIMUM FLOOR LEVEL  
OVERALL ASBUILT PLAN

ORIGINATOR:	DATE:	SIGNED:	PLOT BY:
GKW	04.2019		SXK
DRAWN:	DATE:	SIGNED:	PLOT DATE:
SXK	01.09.20		08.09.20
CHECKED:	DATE:	SIGNED:	SURVEY BY:
SXK	01.09.20		DW
APPROVED:	DATE:	SIGNED:	SURVEY DATE:
SXK	01.09.20		01.08.20
ISSUE STATUS:			
ASBUILT			
PROJECT No:	SCALES:		A1
1050-142875-01	1:1500-A1 1:3000-A3		
DRAWING No:			REV
142875-12-AB470			1

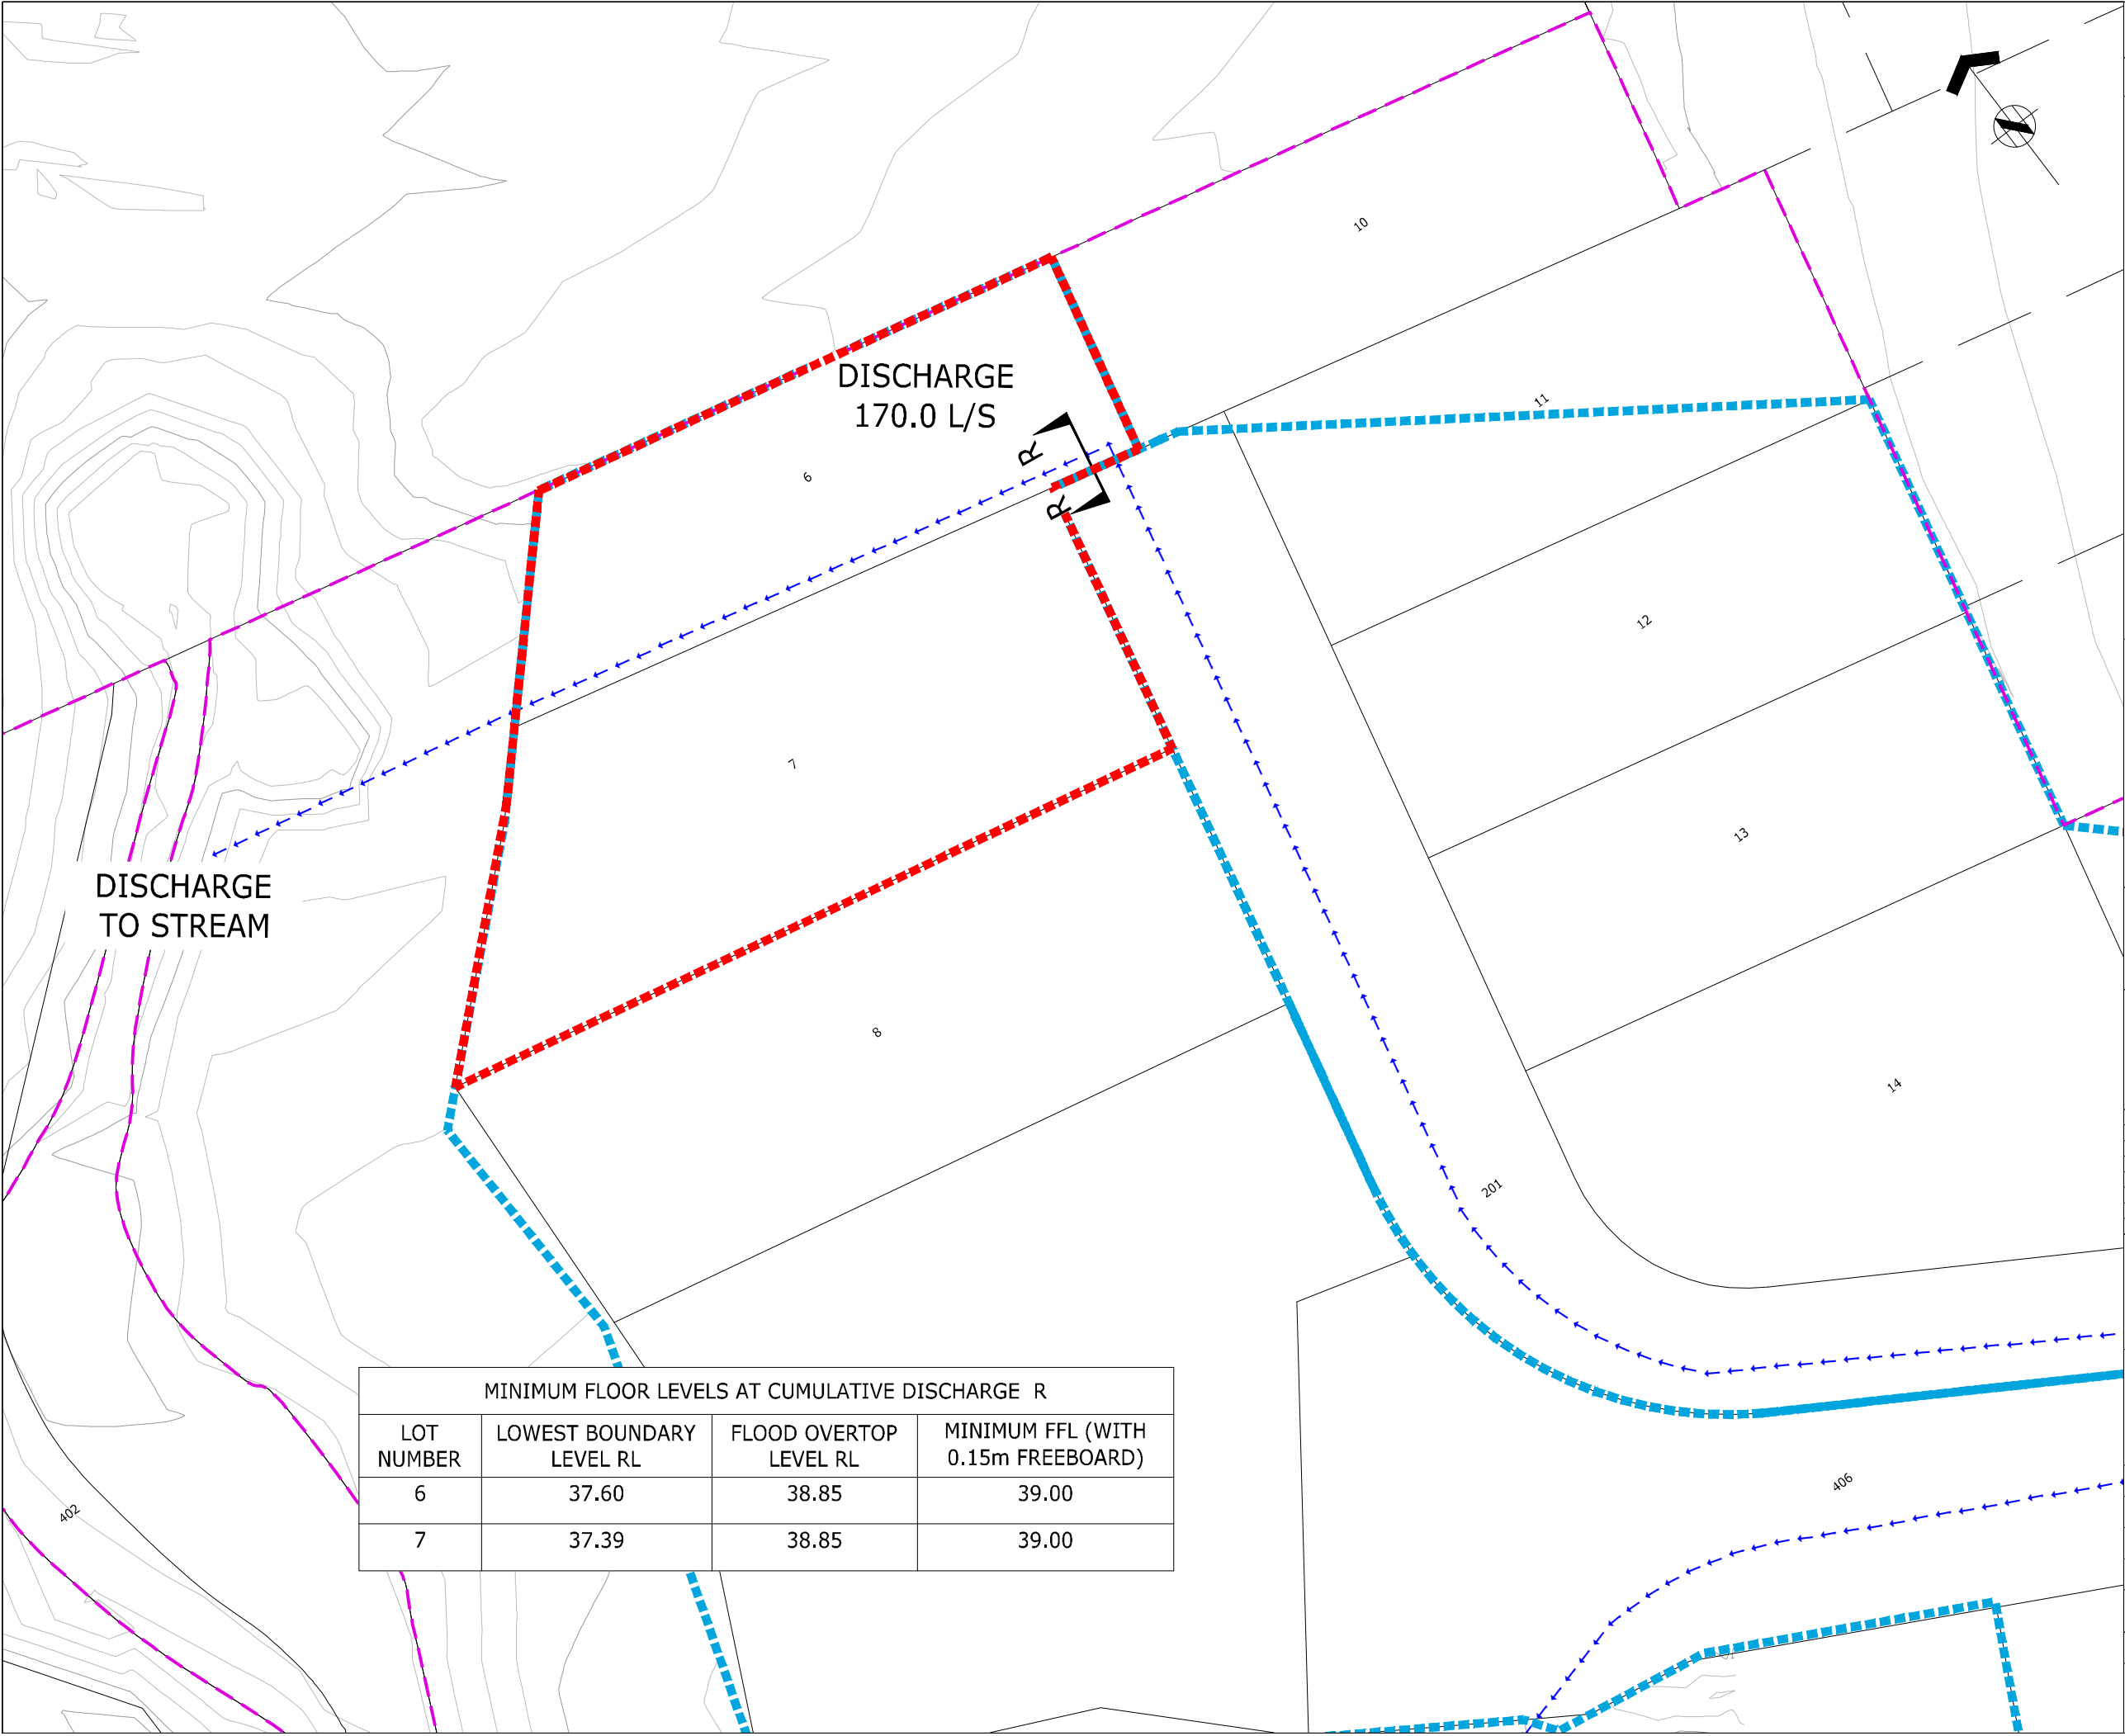



ASSOCIATION OF CONSULTING  
ENGINEERS NEW ZEALAND

ISO 9001  
QUALITY  
ASSURED

THIS DRAWING AND DESIGN REMAINS THE PROPERTY OF, AND MAY NOT BE REPRODUCED  
OR ALTERED, WITHOUT THE WRITTEN PERMISSION OF HARRISON GRIERSON CONSULTANTS  
LIMITED. NO LIABILITY SHALL BE ACCEPTED FOR UNAUTHORISED USE OF THIS DRAWING.

NOTES:

1. LEVELS ARE IN TERMS OF AUCKLAND VERTICAL  
DATUM 1946

ORIGIN OF LEVELS  
SS 66 SO 48643  
RL 54.50

2. COORDINATES ARE IN TERMS OF NZTM.

3. CATCHMENT AREAS AND DISCHARGE FLOWS  
INCORPORATE FUTURE OVERLAND FLOWPATH  
GENERATION FROM UPSTREAM DEVELOPMENT.

LEGEND

EXTENT OF 1% AEP (24 HR)  
FLOOD BEFORE  
OVERTOPPING KERB

PRIVATE LOTS WITH  
MINIMUM FLOOR LEVEL  
REQUIREMENTS

CATCHMENT BOUNDARIES

OVERLAND FLOWPATHS

ENGINEERING APPROVAL  
EPA 60349136

I CERTIFY THAT THESE ASBUILT PLANS ARE AN ACCURATE RECORD OF  
THE WORKS UNDERTAKEN AND THAT:

- THE COORDINATES (X,Y) ARE IN TERMS OF NZTM ON NZGD  
(2000), AND ARE WITHIN ±50mm.
- THE LEVELS (Z) ARE IN TERMS OF THE AUCKLAND 1946 (MSL)  
LINZ DATUM (DOSLI DATUM), AND ARE WITHIN ±10mm.

Signed:   
CHARTERED PROFESSIONAL ENGINEER

Date: ...08/09/2020.....

Name: SHANE KELLY

Phone: 09-917-5000

Email: s.kelly@harrisongrierson.com



HUGH GREEN  
LIMITED



AUCKLAND OFFICE  
LEVEL 4, 96 ST GEORGES BAY ROAD  
PARNELL AUCKLAND 1052  
T +64 9 917 5000  
W www.harrisongrierson.com

1	ASBUILT	SXK	01.09.20
REF	REVISIONS	BY	DATE

PROJECT:

HUGH GREEN LIMITED  
DONEGAL STAGE 11D/12  
36 TIR CONAILL AVENUE, FLAT BUSH

TITLE:

MINIMUM FLOOR LEVEL  
ASBUILT PLAN  
SHEET 1 OF 4


ORIGINATOR: GKW	DATE: 04.2019	SIGNED:	PLOT BY: SXX
DRAWN: SXX	DATE: 01.09.20	SIGNED:	PLOT DATE: 08.09.20
CHECKED: SXX	DATE: 01.09.20	SIGNED:	SURVEY BY: DW
APPROVED: SXX	DATE: 01.09.20	SIGNED:	SURVEY DATE: 01.08.20

ISSUE STATUS:

ASBUILT

PROJECT No: 1050-142875-01	SCALES: 1:200-A1 1:400-A3	A1
DRAWING No: 142875-12-AB471	REV 1	



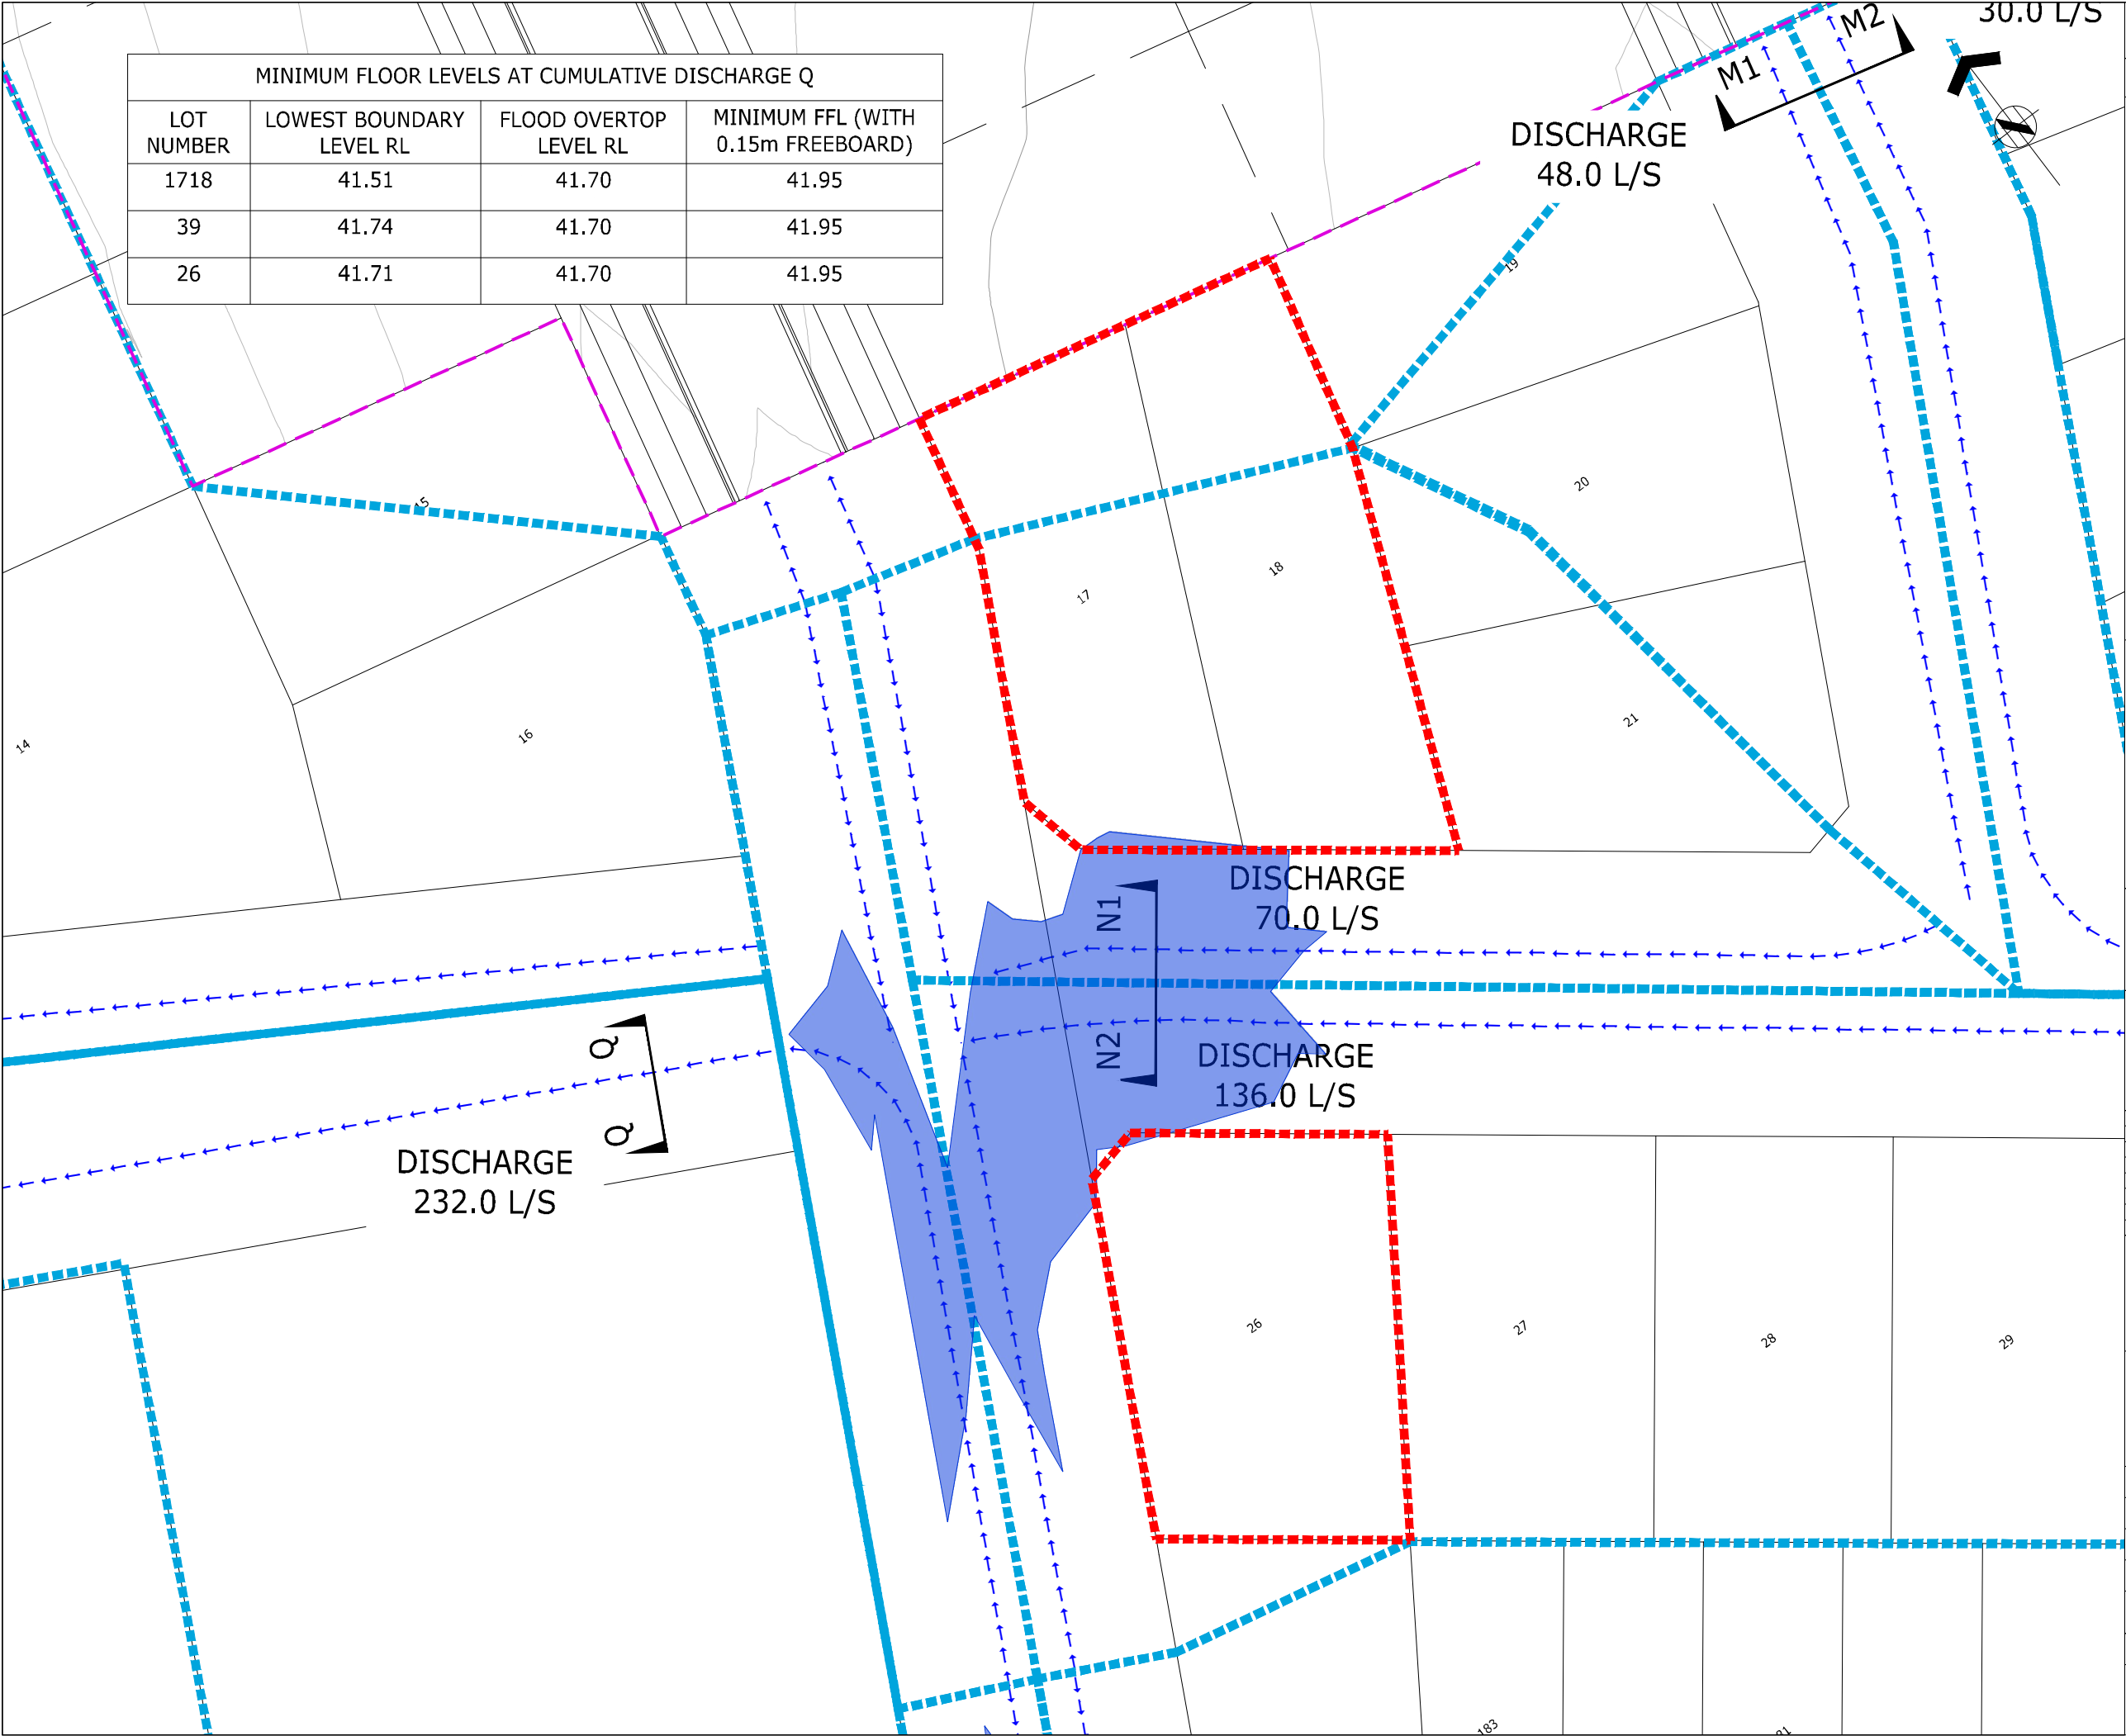

MINIMUM FLOOR LEVELS AT CUMULATIVE DISCHARGE Q			
LOT NUMBER	LOWEST BOUNDARY LEVEL RL	FLOOD OVERTOP LEVEL RL	MINIMUM FFL (WITH 0.15m FREEBOARD)
1718	41.51	41.70	41.95
39	41.74	41.70	41.95
26	41.71	41.70	41.95

THIS DRAWING AND DESIGN REMAINS THE PROPERTY OF, AND MAY NOT BE REPRODUCED OR ALTERED, WITHOUT THE WRITTEN PERMISSION OF HARRISON GRIERSON CONSULTANTS LIMITED. NO LIABILITY SHALL BE ACCEPTED FOR UNAUTHORISED USE OF THIS DRAWING.

- NOTES:
1. LEVELS ARE IN TERMS OF AUCKLAND VERTICAL DATUM 1946

ORIGIN OF LEVELS  
SS 66 SO 48643  
RL 54.50
2. COORDINATES ARE IN TERMS OF NZTM.
3. CATCHMENT AREAS AND DISCHARGE FLOWS INCORPORATE FUTURE OVERLAND FLOWPATH GENERATION FROM UPSTREAM DEVELOPMENT.

- LEGEND
- EXTENT OF 1% AEP (24 HR) FLOOD BEFORE OVERTOPPING KERB

PRIVATE LOTS WITH MINIMUM FLOOR LEVEL REQUIREMENTS


CATCHMENT BOUNDARIES

OVERLAND FLOWPATHS

ENGINEERING APPROVAL  
EPA 60349136

I CERTIFY THAT THESE ASBUILT PLANS ARE AN ACCURATE RECORD OF THE WORKS UNDERTAKEN AND THAT:

- THE COORDINATES (X,Y) ARE IN TERMS OF NZTM ON NZGD (2000), AND ARE WITHIN ±50mm.
- THE LEVELS (Z) ARE IN TERMS OF THE AUCKLAND 1946 (MSL) LINZ DATUM (DOSLI DATUM), AND ARE WITHIN ±10mm.

Signed:   
CHARTERED PROFESSIONAL ENGINEER

Date: ...08/09/2020.....

Name: SHANE KELLY

Phone: 09-917-5000


Email: s.kelly@harrisongrierson.com

HUGH GREEN LIMITED



AUCKLAND OFFICE  
LEVEL 4, 96 ST GEORGES BAY ROAD  
PARNELL AUCKLAND 1052  
T +64 9 917 5000  
W www.harrisongrierson.com



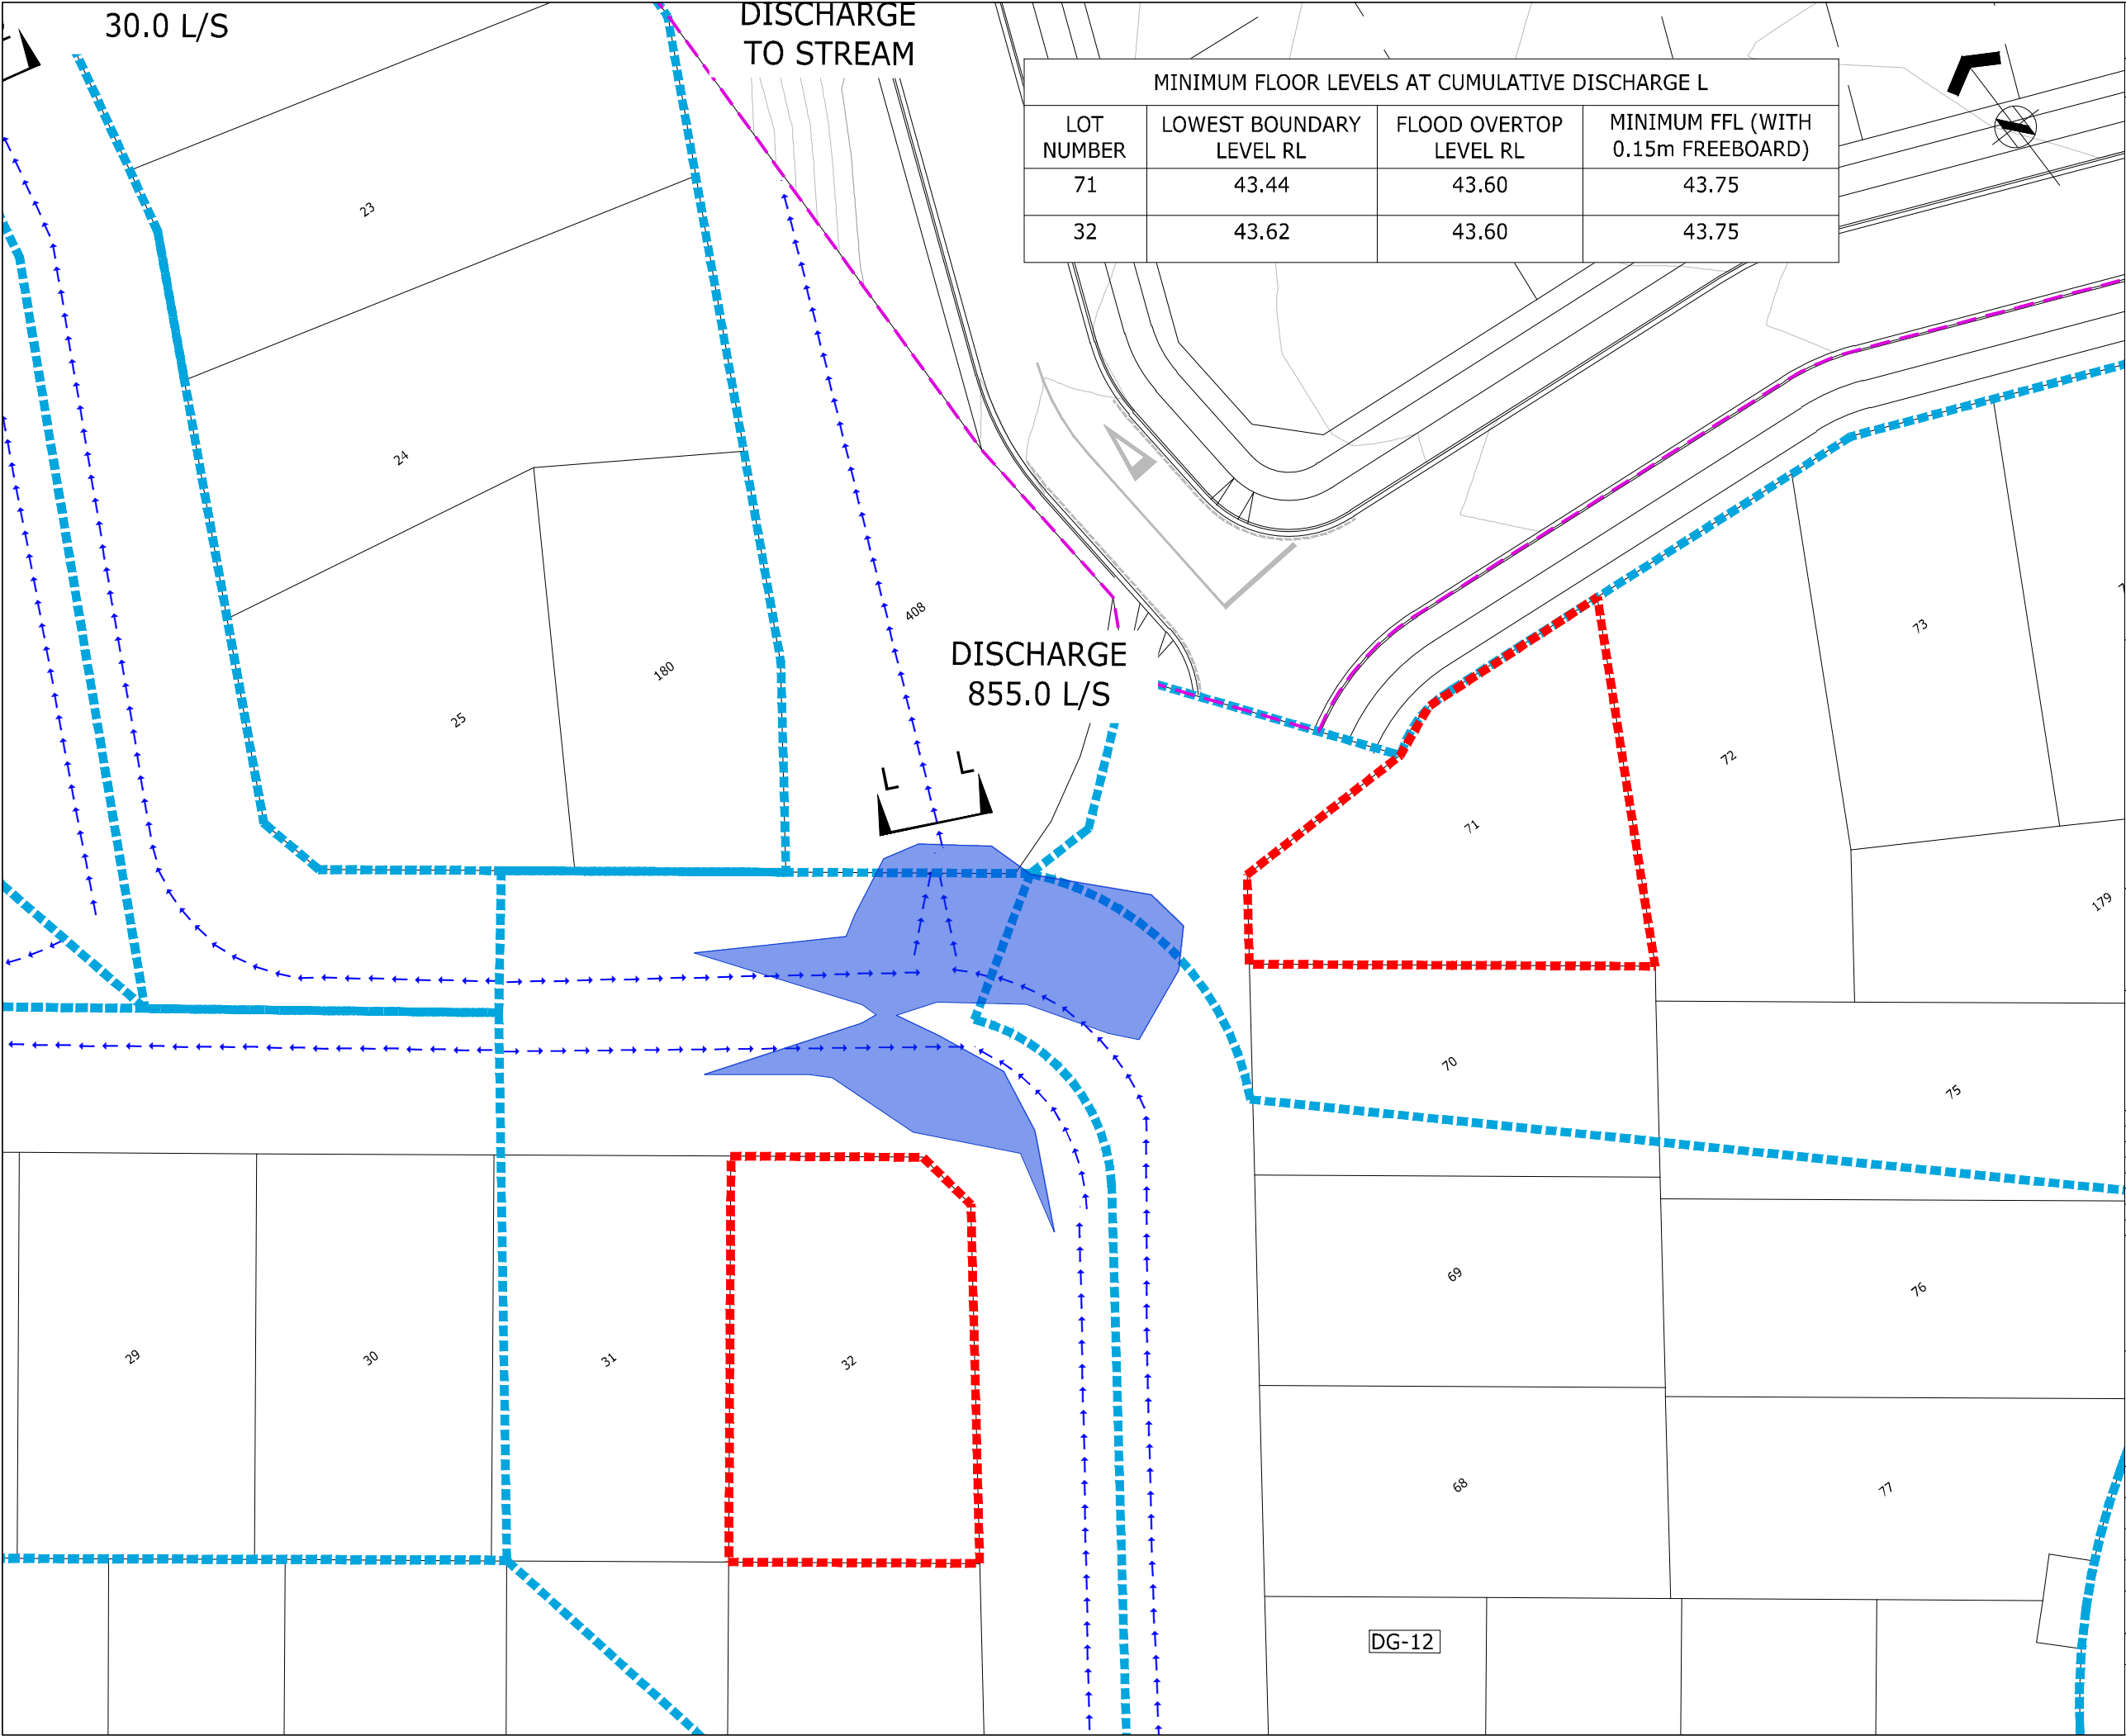

1	ASBUILT	SXK	01.09.20
REF	REVISIONS	BY	DATE
PROJECT:			
HUGH GREEN LIMITED DONEGAL STAGE 11D/12 36 TIR CONAILL AVENUE, FLAT BUSH			
TITLE:			
MINIMUM FLOOR LEVEL ASBUILT PLAN SHEET 2 OF 4			
ORIGINATOR: GKW	DATE: 04.2019	SIGNED:	PLOT BY: SXK
DRAWN: SXK	DATE: 01.09.20	SIGNED:	PLOT DATE: 08.09.20
CHECKED: SXK	DATE: 01.09.20	SIGNED:	SURVEY BY: DW
APPROVED: SXK	DATE: 01.09.20	SIGNED:	SURVEY DATE: 01.08.20
ISSUE STATUS:			
ASBUILT			
PROJECT No: 1050-142875-01	SCALES: 1:200-A1 1:400-A3	A1	
DRAWING No:			REV
142875-12-AB472			1



MINIMUM FLOOR LEVELS AT CUMULATIVE DISCHARGE L			
LOT NUMBER	LOWEST BOUNDARY LEVEL RL	FLOOD OVERTOP LEVEL RL	MINIMUM FFL (WITH 0.15m FREEBOARD)
71	43.44	43.60	43.75
32	43.62	43.60	43.75

THIS DRAWING AND DESIGN REMAINS THE PROPERTY OF, AND MAY NOT BE REPRODUCED OR ALTERED, WITHOUT THE WRITTEN PERMISSION OF HARRISON GRIERSON CONSULTANTS LIMITED. NO LIABILITY SHALL BE ACCEPTED FOR UNAUTHORISED USE OF THIS DRAWING.


- NOTES:**
- LEVELS ARE IN TERMS OF AUCKLAND VERTICAL DATUM 1946  
  
ORIGIN OF LEVELS  
SS 66 SO 48643  
RL 54.50
  - COORDINATES ARE IN TERMS OF NZTM.
  - CATCHMENT AREAS AND DISCHARGE FLOWS INCORPORATE FUTURE OVERLAND FLOWPATH GENERATION FROM UPSTREAM DEVELOPMENT.

- LEGEND**
-  EXTENT OF 1% AEP (24 HR) FOOD BEFORE OVERTOPPING KERB
  -  PRIVATE LOTS WITH MINIMUM FLOOR LEVEL REQUIREMENTS
  -  CATCHMENT BOUNDARIES
  -  OVERLAND FLOWPATHS

ENGINEERING APPROVAL  
EPA 60349136

I CERTIFY THAT THESE ASBUILT PLANS ARE AN ACCURATE RECORD OF THE WORKS UNDERTAKEN AND THAT:

- THE COORDINATES (X,Y) ARE IN TERMS OF NZTM ON NZGD (2000), AND ARE WITHIN ±50mm.
- THE LEVELS (Z) ARE IN TERMS OF THE AUCKLAND 1946 (MSL) LINZ DATUM (DOSLI DATUM), AND ARE WITHIN ±10mm.

Signed:  CHARTERED PROFESSIONAL ENGINEER

Date: ...08/09/2020.....

Name: SHANE KELLY

Phone: 09-917-5000


Email: s.kelly@harrisongrierson.com

 HUGH GREEN GROUP

HUGH GREEN LIMITED



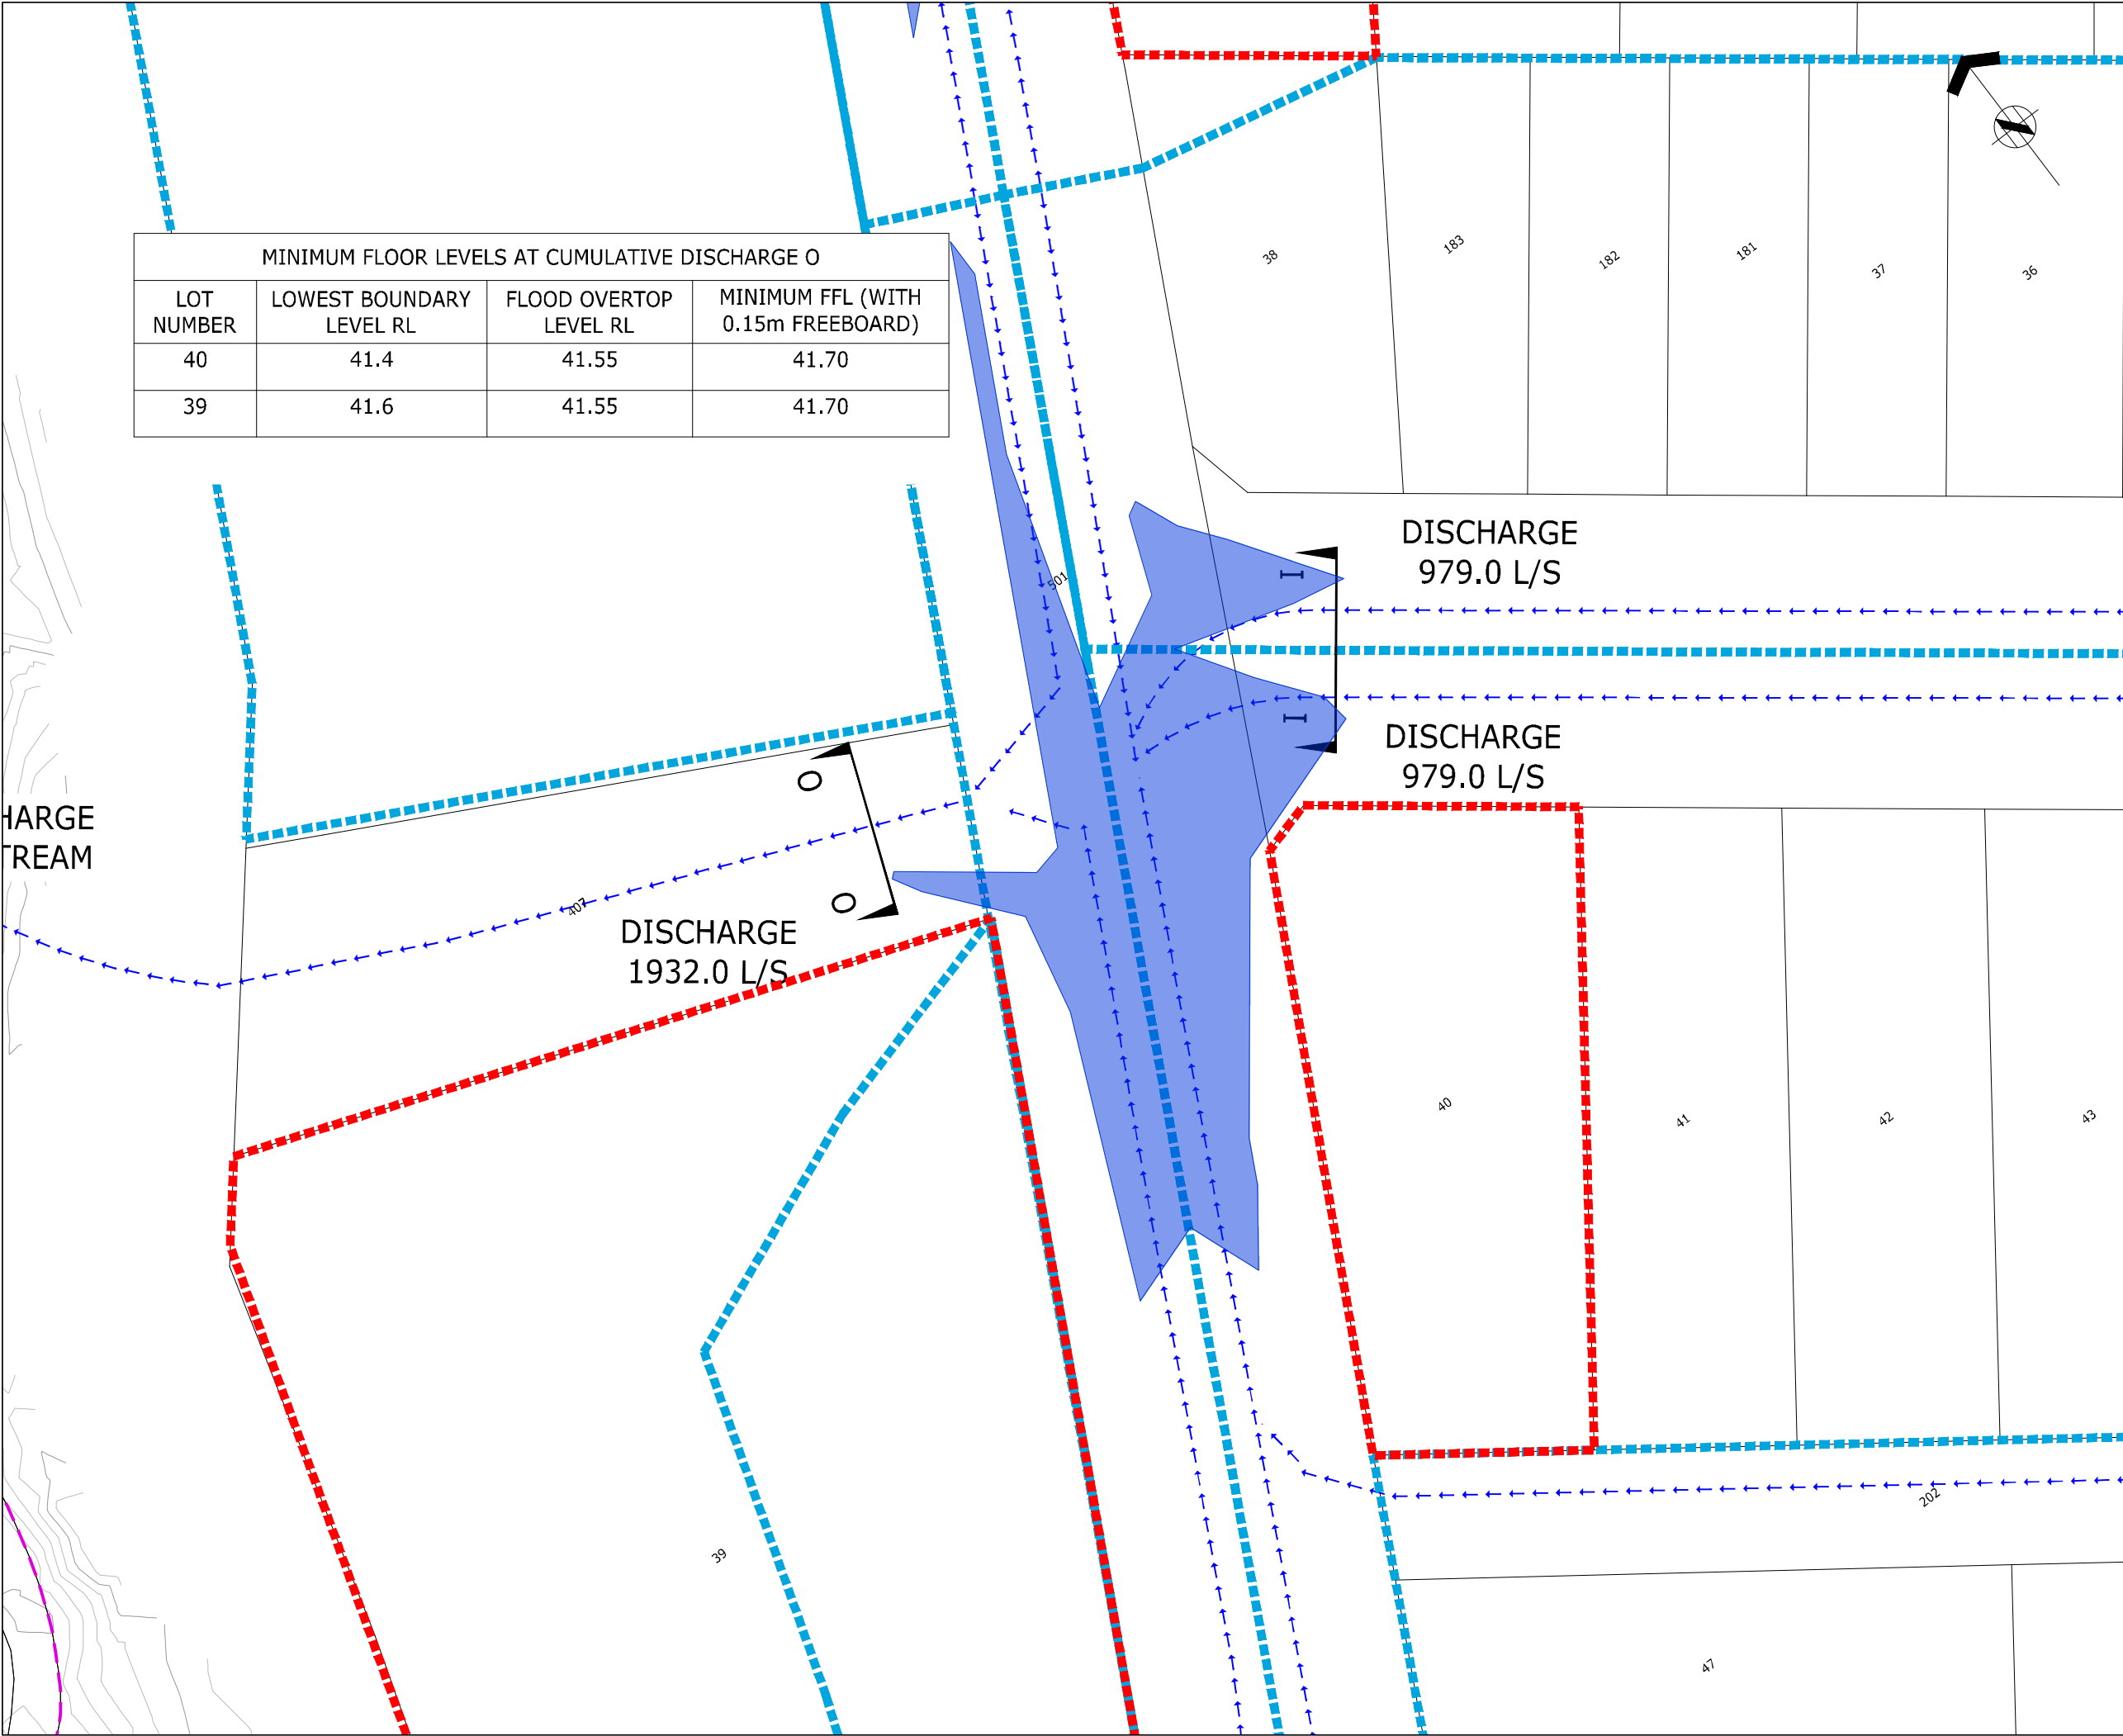

 AUCKLAND OFFICE  
LEVEL 4, 96 ST GEORGES BAY ROAD  
PARNELL AUCKLAND 1052  
T +64 9 917 5000  
W www.harrisongrierson.com

1	ASBUILT		SXK	01.09.20	
REF	REVISIONS		BY	DATE	
PROJECT:					
HUGH GREEN LIMITED DONEGAL STAGE 11D/12 36 TIR CONAILL AVENUE, FLAT BUSH					
TITLE:					
MINIMUM FLOOR LEVEL ASBUILT PLAN SHEET 3 OF 4					
ORIGINATOR:	DATE:	SIGNED:	PLOT BY:		
GKW	04.2019		SXK		
DRAWN:	DATE:	SIGNED:	PLOT DATE:		
SXK	01.09.20		08.09.20		
CHECKED:	DATE:	SIGNED:	SURVEY BY:		
SXK	01.09.20		DW		
APPROVED:	DATE:	SIGNED:	SURVEY DATE:		
SXK	01.09.20		01.08.20		
ISSUE STATUS:					
ASBUILT					
PROJECT No:		SCALES:		A1	
050-142875-01		1:200-A1 1:400-A3			
DRAWING No:				REV	
142875-12-AB473				1	



MINIMUM FLOOR LEVELS AT CUMULATIVE DISCHARGE O			
LOT NUMBER	LOWEST BOUNDARY LEVEL RL	FLOOD OVERTOP LEVEL RL	MINIMUM FFL (WITH 0.15m FREEBOARD)
40	41.4	41.55	41.70
39	41.6	41.55	41.70


- NOTES:**
- LEVELS ARE IN TERMS OF AUCKLAND VERTICAL DATUM 1946  
  
ORIGIN OF LEVELS  
SS 66 SO 48643  
RL 54.50
  - COORDINATES ARE IN TERMS OF NZTM.
  - CATCHMENT AREAS AND DISCHARGE FLOWS INCORPORATE FUTURE OVERLAND FLOWPATH GENERATION FROM UPSTREAM DEVELOPMENT.

- LEGEND**
-  EXTENT OF 1% AEP (24 HR) FLOOD BEFORE OVERTOPPING KERB
  -  PRIVATE LOTS WITH MINIMUM FLOOR LEVEL REQUIREMENTS
  -  CATCHMENT BOUNDARIES
  -  OVERLAND FLOWPATHS

ENGINEERING APPROVAL  
EPA 60349136

I CERTIFY THAT THESE ASBUILT PLANS ARE AN ACCURATE RECORD OF THE WORKS UNDERTAKEN AND THAT:

- THE COORDINATES (X,Y) ARE IN TERMS OF NZTM ON NZGD (2000), AND ARE WITHIN ±50mm.
- THE LEVELS (Z) ARE IN TERMS OF THE AUCKLAND 1946 (MSL) LINZ DATUM (DOSLI DATUM), AND ARE WITHIN ±10mm.

Signed:  CHARTERED PROFESSIONAL ENGINEER

Date: ...08/09/2020.....

Name: SHANE KELLY

Phone: 09-917-5000

Email: s.kelly@harrisingrierson.com

 HUGH GREEN LIMITED



AUCKLAND OFFICE  
LEVEL 4, 96 ST GEORGES BAY ROAD  
PARNELL AUCKLAND 1052  
T +64 9 917 5000  
W www.harrisingrierson.com

1	ASBUILT	SXK	01.09.20
REF	REVISIONS	BY	DATE

HUGH GREEN LIMITED  
DONEGAL STAGE 11D/12  
36 TIR CONAILL AVENUE, FLAT BUSH

TITLE:

MINIMUM FLOOR LEVEL  
ASBUILT PLAN  
SHEET 4 OF 4

ORIGINATOR:	DATE:	SIGNED:	PLOT BY:
GKW	04.2019		SXK
DRAWN:	DATE:	SIGNED:	PLOT DATE:
SXK	01.09.20		08.09.20
CHECKED:	DATE:	SIGNED:	SURVEY BY:
SXK	01.09.20		DW
APPROVED:	DATE:	SIGNED:	SURVEY DATE:
SXK	01.09.20		01.08.20

ISSUE STATUS: ASBUILT

PROJECT No:	SCALES:	A1
1050-142875-01	1:200-A1 1:400-A3	
DRAWING No:		REV
142875-12-AB474		1