


# DONEGAL GLEN STAGE 15 A&C

Stormwater

Minimum Floor Levels Report

Hugh Green Limited

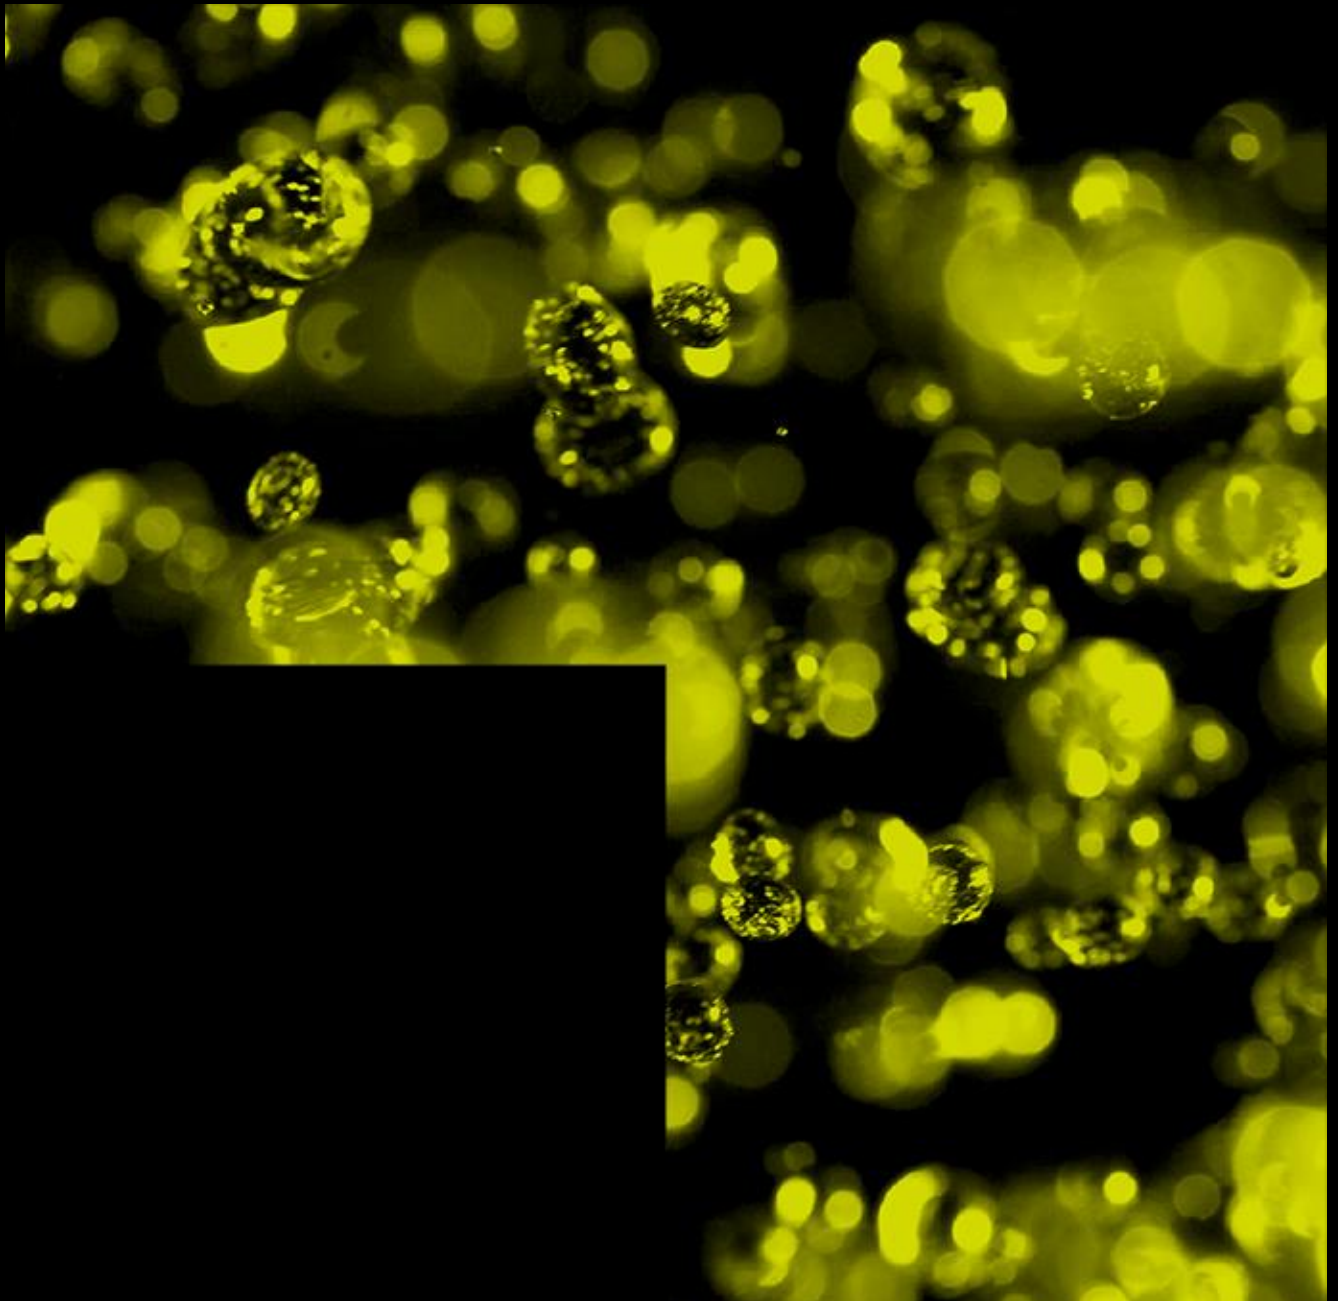

## DOCUMENT CONTROL RECORD

<b>CLIENT</b>	Hugh Green Limited
<b>PROJECT</b>	Donegal Glen Stage 15 A&C
<b>HG PROJECT NO.</b>	1050-146689-01
<b>HG DOCUMENT NO.</b>	R001v1-146689-01-MFL
<b>DOCUMENT</b>	Stormwater Report – Minimum Floor Levels

## ISSUE AND REVISION RECORD

<b>DATE OF ISSUE</b>	18 February 2022
<b>STATUS</b>	Final



<b>ORIGINATOR</b>	Will Kirk – Graduate Civil Engineer
-------------------	-------------------------------------



<b>REVIEWED</b>	Daniel Scott – Technical Manager
-----------------	----------------------------------



<b>APPROVED FOR ISSUE</b>	Daniel Scott – Technical Manager
---------------------------	----------------------------------

<b>OFFICE OF ORIGIN</b>	Parnell
<b>TELEPHONE</b>	+64 9 917 5000
<b>EMAIL</b>	w.kirk@harrisingrierson.com

# CONTENTS

<b>1.0</b>	<b>INTRODUCTION .....</b>	<b>1</b>
<b>2.0</b>	<b>RESPONSE TO REQUIREMENTS .....</b>	<b>2</b>
2.1	Identification of 1% AEP Flood Level.....	2
2.2	OLFP Layout Plan .....	2
2.3	As-Built Cross Sections.....	2
2.4	Minimum Floor Levels .....	2
<b>3.0</b>	<b>SUMMARY .....</b>	<b>3</b>
 <b>APPENDICES</b>		
Appendix 1	Overland Flow Path & 1% AEP As-built Plans	
Appendix 2	Overland Flow As-built Cross Sections	
Appendix 3	Overland Flow Calculations	

## 1.0 INTRODUCTION

This Stormwater Report has been prepared to fulfil the requirements of the Auckland Council Condition of Consent 65 – Minimum Floor Levels (BUN60356333-B) for Donegal Glen Stage 15 A&C.

The purpose of the report is to satisfy the requirements set out under Condition 65 as follows:

- (i) The 1% AEP flood level for the site and the surrounding road reserves;
- (ii) A layout plan of the overland flow paths for the site and the adjacent land along the boundary in accordance with the approved EPA before Section 223 approval;
- (iii) The overland flow path plan shall include as built cross sections of all roads including the ponding areas with levels before overtopping;
- (iv) As built longitudinal plan and cross sections for shall be provided for overland flow path locations;
- (v) The minimum floor level of all habitable buildings must be at least 150mm for flows below 2m<sup>3</sup> per second and 100 mm deep and where flows exceed this, the minimum floor level of habitable buildings must be increased to at least 500mm. This may be enforced through a consent notice on the property unless the building consents have already been issued; and
- (vi) Where either existing or proposed overland flow paths cross lot boundaries, the consent holder is to provide the Council with plans to accompany easement(s) to be registered in favour of the Council.

## **2.0 RESPONSE TO REQUIREMENTS**

### **2.1 IDENTIFICATION OF 1% AEP FLOOD LEVEL**

#### **1% AEP – Road Flows**

The secondary flows, up to and including the 1% AEP storm event, are contained within the road (i.e. kerb to kerb), as shown in overland flow path as-built plans and cross-section drawings AB455-456 and AB 466 in Appendix 1 & 2 for Koromeke Street, Uru Drive, Crossgar Drive, Brackloon Lane, and Ballyalton Crescent.

#### **1% AEP – Flows outside the Road Reserve**

All flows are contained within the road reserve.

### **2.2 OLFP LAYOUT PLAN**

A layout plan of the as-built OLFPs for this site and adjacent land along the boundary can be seen in as-built drawings AB466 in Appendix 1.

### **2.3 AS-BUILT CROSS SECTIONS**

The as-built cross-sections of all roads with levels, depth, width, and velocity of flow can be seen in as-built drawings AB455 & AB456 in Appendix 2.

### **2.4 MINIMUM FLOOR LEVELS**

Where flows exceed  $2 \text{ m}^3/\text{s}$ , the minimum floor level of any habitable buildings must be 500mm above the 1% AEP flood level to comply with Chapter 4 of the Code of Practice for Land Development and Subdivision 2015. Overland flows generated from this subdivision are less than  $2 \text{ m}^3/\text{s}$ , so a minimum of 150 mm freeboard must be provided.

In this residential subdivision there are no private lots that require a specified minimum floor level, due to the flows being less than  $2 \text{ m}^3/\text{s}$  and the overland flow (1% AEP) being contained within the carriageways.

## 3.0 SUMMARY

This stormwater report for Minimum Floor Levels was prepared to satisfy Auckland Council Resource Consent (BUN60356333-B), specifically condition 65. This report addresses how this condition is met on the Donegal Glen Stage 15 A&C residential subdivision.

The 1% AEP flood event is entirely contained within the road reserve. The overall layout plan in Appendix 1 and cross-sections in Appendix 2 show both the flow directions and the depths of the overland flow through the road sections. Appendix 3 is the calculations for the overland flows.

N:\1050\146689\_01\500 Del\550 Compliance\224c Application - Stage 15\06. 224c Application\04. Appendices\Appendix 15 - Condition 106 - Stormwater Report\DG15 - MFL Report.docx



# APPENDICES



# **APPENDIX 1**

## **OVERLAND FLOW PATH & 1% AEP**

### **AS-BUILT PLANS**






## **APPENDIX 2**

# **OVERLAND FLOW AS-BUILT CROSS SECTIONS**

NOTES:

- LEVELS ARE IN TERMS OF AUCKLAND VERTICAL DATUM 1946  
  
ORIGIN OF LEVELS  
SS 66 50 48643  
RL 54.50
- CATCHMENT AREAS AND DISCHARGE FLOWS INCORPORATE FUTURE OVERLAND FLOWPATH GENERATION FROM UPSTREAM DEVELOPMENT.
- ALL FLOWPATHS ARE WITHIN THE LEGAL ROAD WIDTH.

LEGEND

 OVERLAND FLOWPATH  
LEVEL IN 1% AEP  
STORM EVENT

ENGINEERING APPROVAL  
ENG-60363080

I CERTIFY THAT THESE ASBUILT PLANS ARE AN ACCURATE RECORD OF THE WORKS UNDERTAKEN AND THAT:

- THE COORDINATES (X,Y) ARE IN TERMS OF NZTM ON NZGD (2000), AND ARE WITHIN ±50mm.
- THE LEVELS (Z) ARE IN TERMS OF THE AUCKLAND 1946 (MSL) LINZ DATUM (DOSLI DATUM), AND ARE WITHIN ±25mm.

Signed:   
CHARTERED PROFESSIONAL ENGINEER

Date: 24/01/2022  
Name: DANIEL ALEXANDER HOWARD SCOTT  
Phone: 09-917-5000  
Email: d.scott@harrisongrierson.com

 AUCKLAND OFFICE  
LEVEL 4, 96 ST GEORGES BAY ROAD  
PARNELL AUCKLAND 1052  
T +64 9 917 5000  
W www.harrisongrierson.com

A	AS-BUILT	WXX	10.12.21
REF	REVISIONS	BY	DATE

PROJECT:

HUGH GREEN LIMITED  
DONEGAL STAGES 15  
36 TIR CONAILL AVENUE, FLAT BUSH

TITLE:


OVERLAND FLOW PATH  
AS-BUILT CROSS SECTIONS  
SHEET 1 OF 2

ORIGINATOR: DXK	DATE: 01.2020	SIGNED:	PLOT BY: WXX
DRAWN: LAL	DATE: 10.12.21	SIGNED:	PLOT DATE: 03.02.22
CHECKED: WXX	DATE: 01.2022	SIGNED:	SURVEY BY:
APPROVED: DAS	DATE: 24.01.22	SIGNED:	SURVEY DATE:


ISSUE STATUS:

AS-BUILT


PROJECT No: 1050-146689-01	SCALES: AS SHOWN	A1
DRAWING No:		REV
146689-15-AB455		A

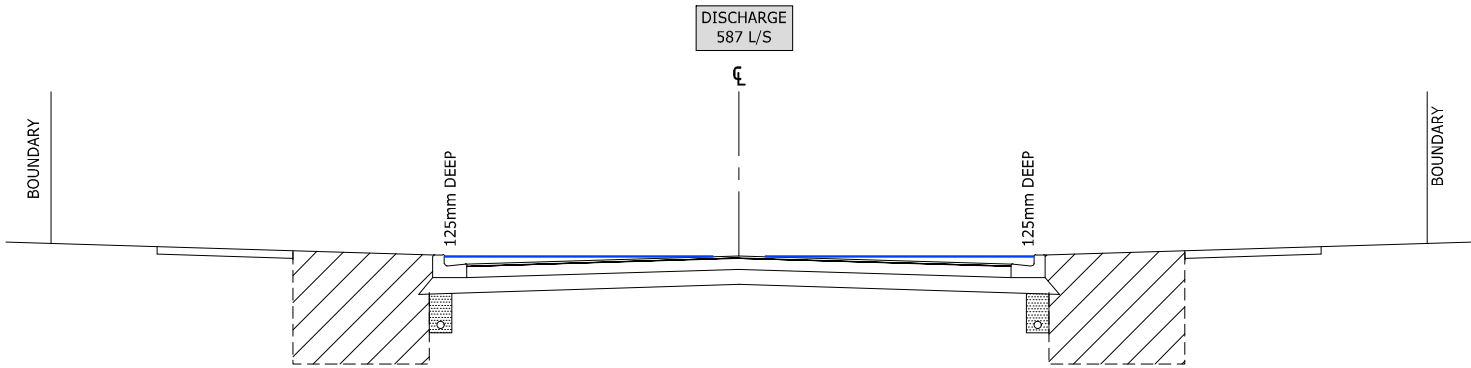

A ROAD 1 OLFP CROSS SECTION A-A  
466 SCALE 1:50-A1  
1:100-A3

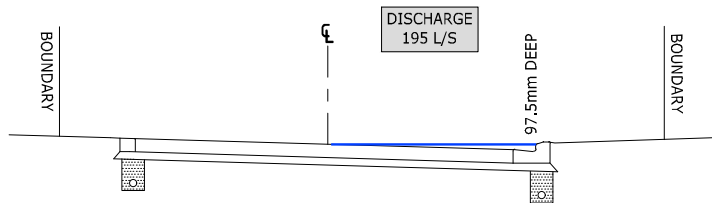

B JOAL 1 OLFP CROSS SECTION B-B  
466 SCALE 1:50-A1  
1:100-A3

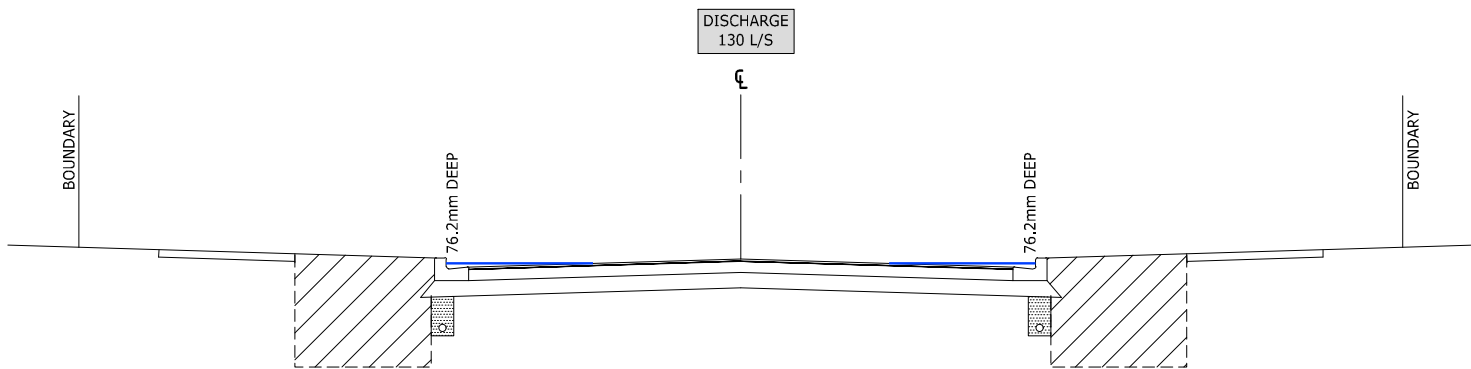

Q ROAD 3 OLFP CROSS SECTION Q-Q  
466 SCALE 1:50-A1  
1:100-A3

NOTES:

- LEVELS ARE IN TERMS OF AUCKLAND VERTICAL DATUM 1946  
  
ORIGIN OF LEVELS  
SS 66 50 48643  
RL 54.50
- CATCHMENT AREAS AND DISCHARGE FLOWS INCORPORATE FUTURE OVERLAND FLOWPATH GENERATION FROM UPSTREAM DEVELOPMENT.
- ALL FLOWPATHS ARE WITHIN THE LEGAL ROAD WIDTH.

LEGEND

 OVERLAND FLOWPATH  
LEVEL IN 1% AEP  
STORM EVENT

ENGINEERING APPROVAL  
ENG-60363080

I CERTIFY THAT THESE ASBUILT PLANS ARE AN ACCURATE RECORD OF THE WORKS UNDERTAKEN AND THAT:

- THE COORDINATES (X,Y) ARE IN TERMS OF NZTM ON NZGD (2000), AND ARE WITHIN ±50mm.
- THE LEVELS (Z) ARE IN TERMS OF THE AUCKLAND 1946 (MSL) LINZ DATUM (DOSLI DATUM), AND ARE WITHIN ±25mm.

Signed:   
CHARTERED PROFESSIONAL ENGINEER

Date: 24/01/2022  
Name: DANIEL ALEXANDER HOWARD SCOTT  
Phone: 09-917-5000  
Email: d.scott@harrisongrierson.com

 AUCKLAND OFFICE  
LEVEL 4, 96 ST GEORGES BAY ROAD  
PARNELL AUCKLAND 1052  
T +64 9 917 5000  
W www.harrisongrierson.com

A	AS-BUILT	WVK	10.12.21
REF	REVISIONS	BY	DATE

PROJECT:

HUGH GREEN LIMITED  
DONEGAL STAGES 15  
36 TIR CONAILL AVENUE, FLAT BUSH

TITLE:


OVERLAND FLOW PATH  
AS-BUILT CROSS SECTIONS  
SHEET 2 OF 2

ORIGINATOR: DXK	DATE: 01.2020	SIGNED:	PLOT BY: WVK
DRAWN: LAL	DATE: 10.12.21	SIGNED:	PLOT DATE: 03.02.22
CHECKED: WVK	DATE: 01.2022	SIGNED:	SURVEY BY:
APPROVED: DAS	DATE: 24.01.22	SIGNED:	SURVEY DATE:

ISSUE STATUS:

AS-BUILT

PROJECT No: 1050-146689-01	SCALES: AS SHOWN	A1
DRAWING No:		REV
146689-15-AB456		A

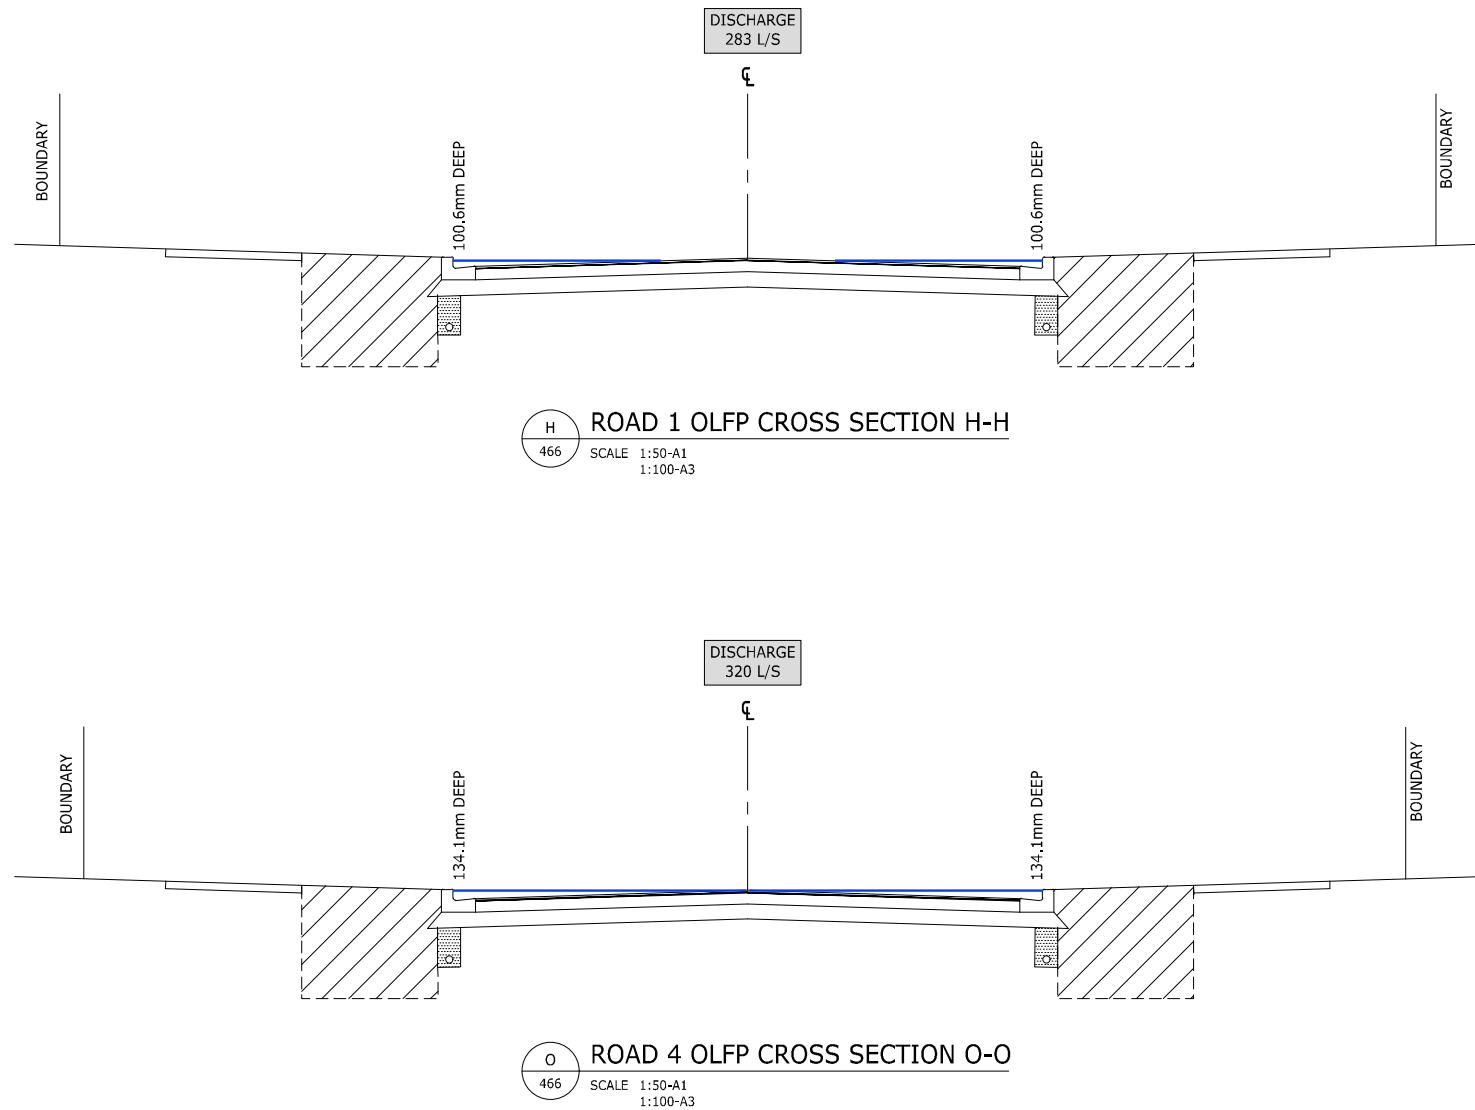

## **APPENDIX 3**

# **OVERLAND FLOW CALCULATIONS**

36 Tir Conaill Av. - Donegal 14, 15A & 15B

HG PROJECT NUMBER: 1050-146689-01  
DATE: 2/04/2020



Runoff Coefficient - C	0.8	
Rainfall Intensity (100year) - I	183	mm/hour
Total Catchment Area	6.14	ha

$Q = CIA \times 2.78 / 1000$

CATCHMENT	AREA (ha)
1	1.4427
2	0.4793
3	0.5782
4	0.6218
6	0.0639
7	0.6943
8	0.4255
9	0.632
10	1.116
12	0.0833

CROSS SECTION	CATCHMENT	AREA (Ha)	Q (m³/s)	EXISTING DISCHARGE	CUMALATIVE FLOW
A	1	1.443	0.587		
B	2	0.479	0.195		
C	3	0.578	0.235		
D	4	0.622	0.253		
F	6	0.064	0.026	1.040	1.066
G					1.066
H	7	0.694	0.283		
I	8	0.426	0.173		
J	9	0.632	0.257		0.713
K	10	1.116	0.454		
M	12	0.083	0.034	1.040	1.074
N					1.074

Notes:

Discharge Point

Discharge Point

\*OLF Path & Catchment plans refer to drawings:  
146689-465  
146689-466  
146689-467  
146689-468

CROSS SECTIONS AT SPEED TABLES

	0.785
	0.451
	0.319

O		0.785	0.319		
P		0.451	0.184		
Q		0.319	0.130		

# Channel Report

Hydraflow Express Extension for Autodesk® AutoCAD® Civil 3D® by Autodesk, Inc.

Wednesday, Jul 22 2020

## Section A-A

### User-defined

Invert Elev (m) = 64.2900  
Slope (%) = 5.3000  
N-Value = 0.013

### Calculations


Compute by: Known Q  
Known Q (cms) = 0.5870

### Highlighted

Depth (m) = 0.1067  
Q (cms) = 0.5870  
Area (sqm) = 0.2902  
Velocity (m/s) = 2.0226  
Wetted Perim (m) = 6.9527  
Crit Depth, Yc (m) = 0.1500  
Top Width (m) = 6.7344  
EGL (m) = 0.3154

### (Sta, El, n)-(Sta, El, n)...

(0.0000, 64.4400)-(0.3000, 64.3200, 0.013)-(3.9000, 64.4100, 0.013)-(7.5000, 64.3200, 0.013)-(7.8000, 64.2900, 0.013)-(7.8000, 64.4400, 0.013)

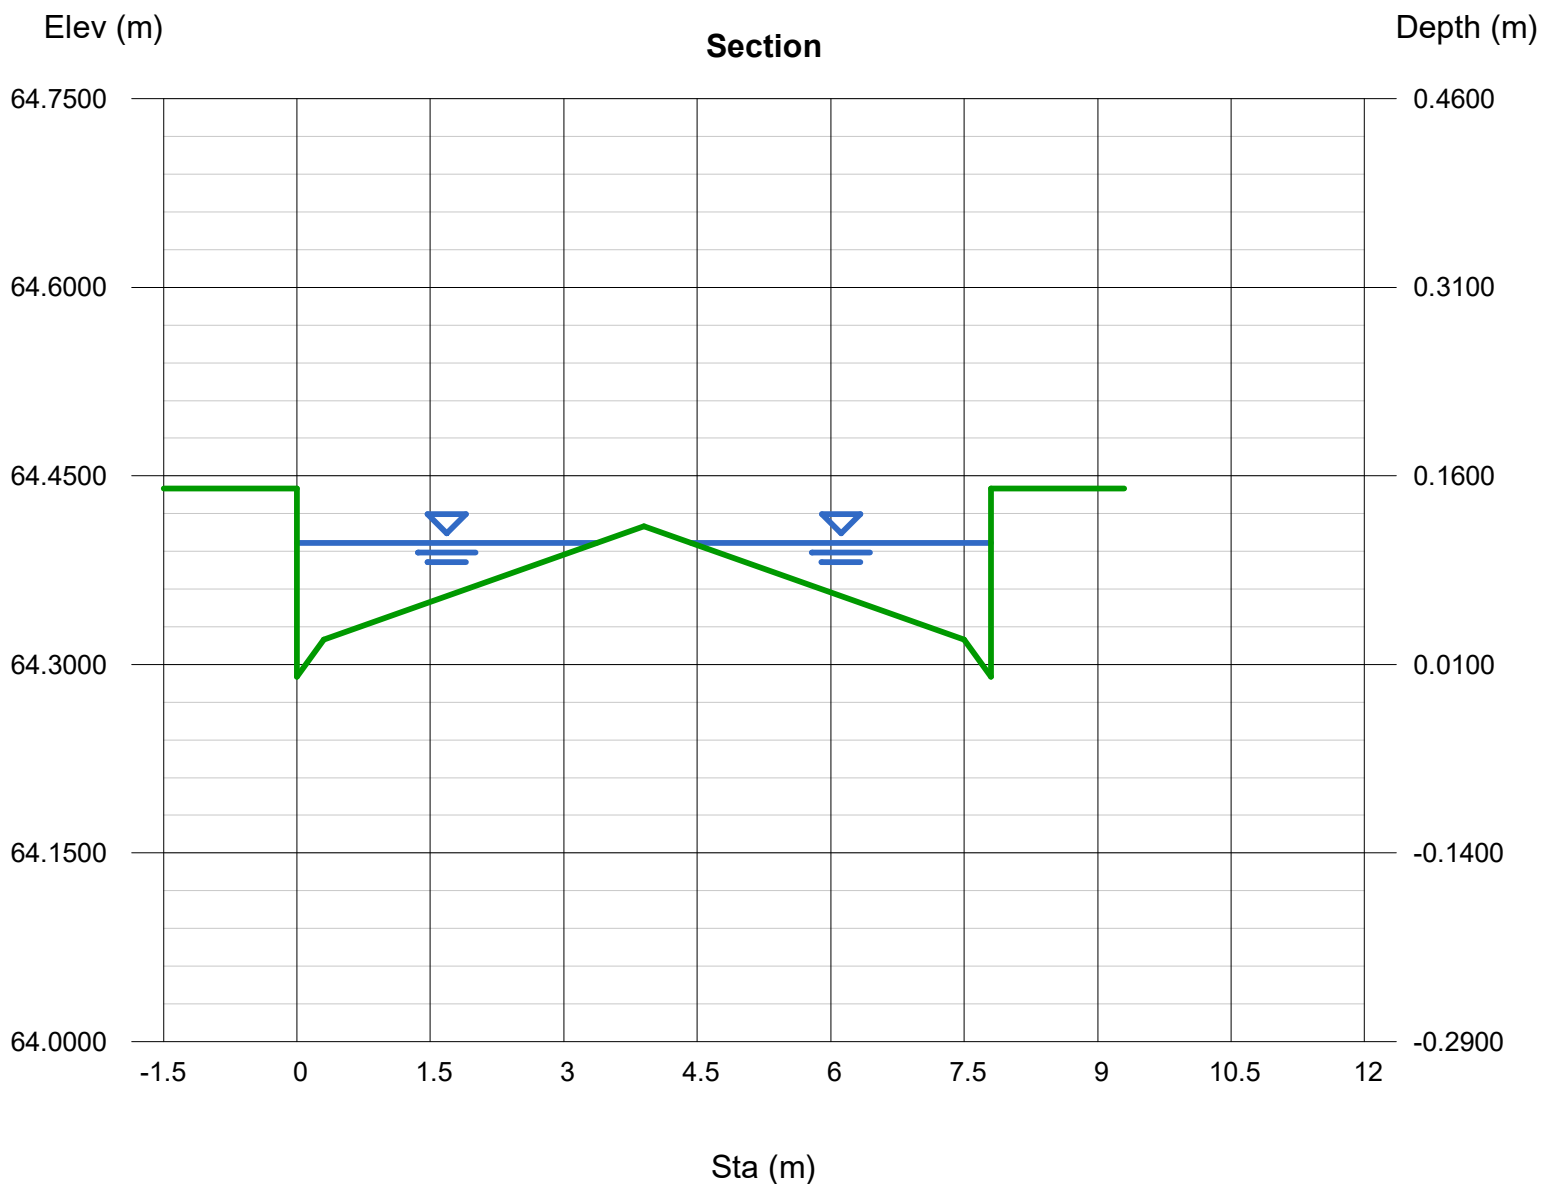

# Channel Report

Hydraflow Express Extension for Autodesk® AutoCAD® Civil 3D® by Autodesk, Inc.

Wednesday, Apr 8 2020

## Section B-B

### User-defined

Invert Elev (m) = 61.4900  
Slope (%) = 6.1000  
N-Value = 0.013

### Calculations


Compute by: Known Q  
Known Q (cms) = 0.1950

### Highlighted

Depth (m) = 0.0975  
Q (cms) = 0.195  
Area (sqm) = 0.0982  
Velocity (m/s) = 1.9862  
Wetted Perim (m) = 2.5740  
Crit Depth, Yc (m) = 0.1463  
Top Width (m) = 2.4740  
EGL (m) = 0.2988

(Sta, El, n)-(Sta, El, n)...

(0.0000, 61.6800)-(2.6250, 61.6000, 0.013)-(5.2000, 61.5200, 0.013)-(5.5000, 61.4900, 0.013)-(5.5000, 61.6400, 0.013)

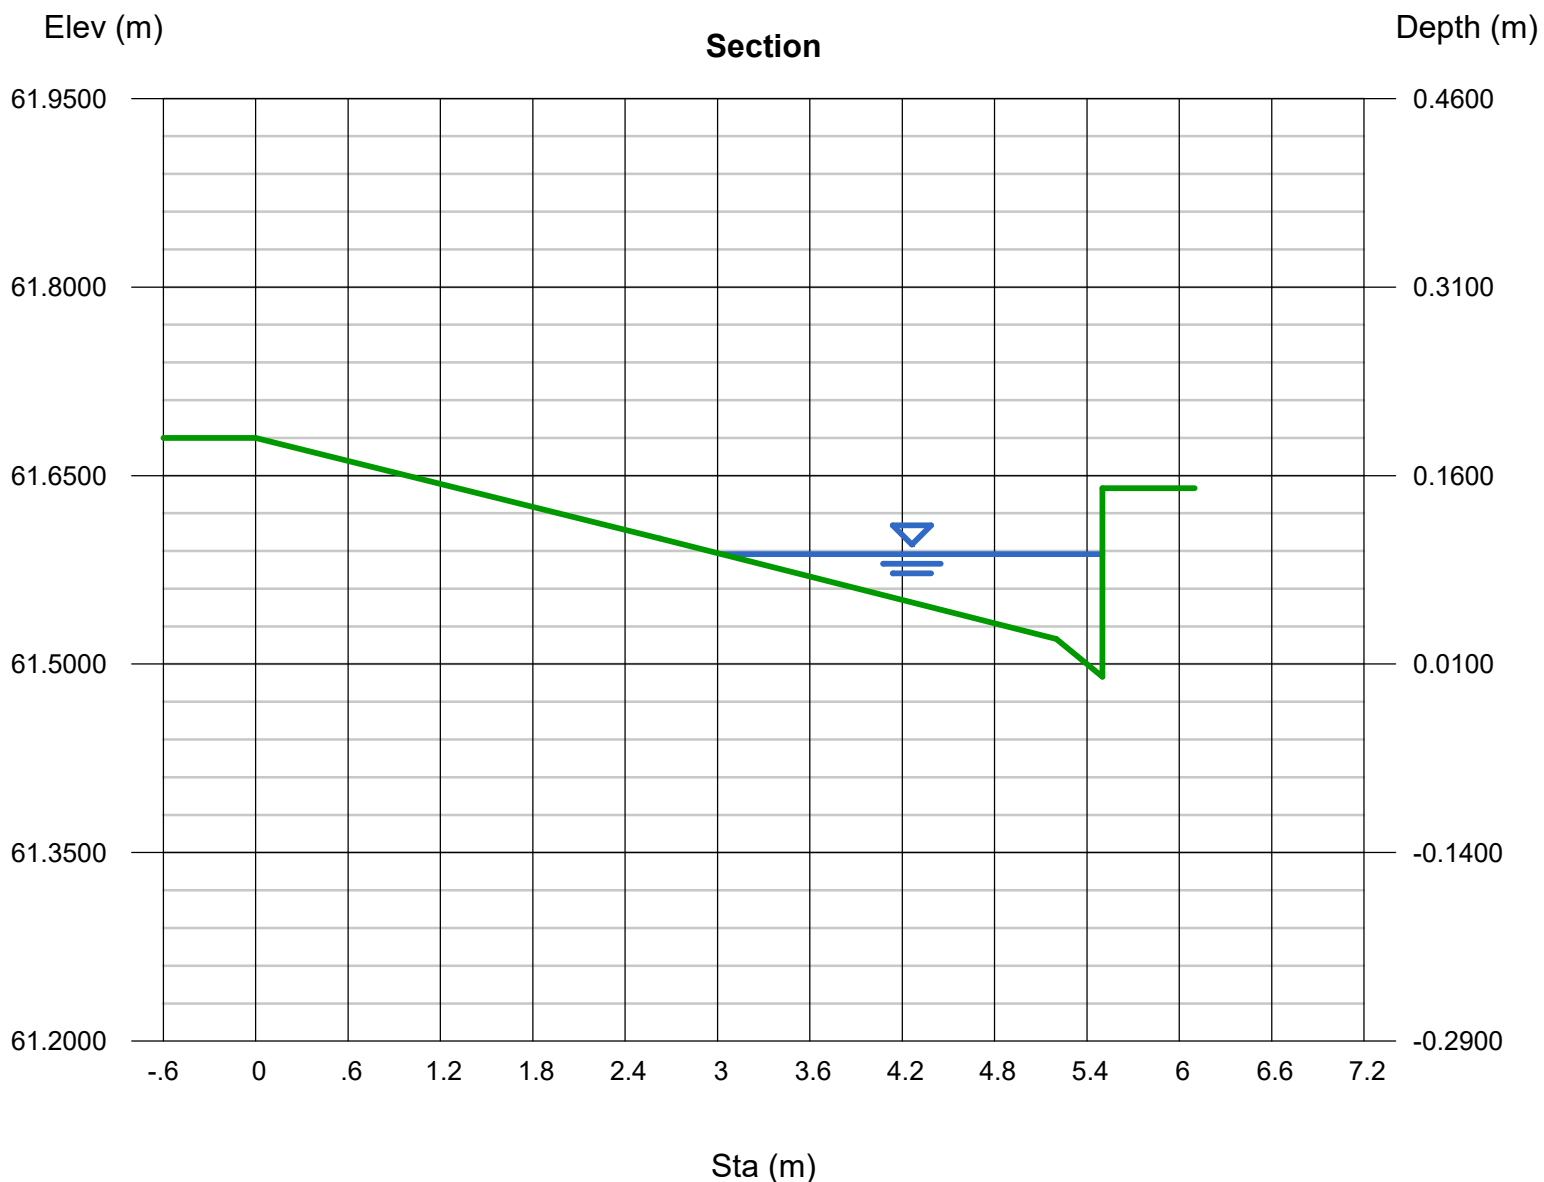



# Channel Report

Hydraflow Express Extension for Autodesk® AutoCAD® Civil 3D® by Autodesk, Inc.

Wednesday, Apr 8 2020

## Section C-C

### User-defined

Invert Elev (m) = 61.4000  
Slope (%) = 5.7000  
N-Value = 0.013

### Calculations


Compute by: Known Q  
Known Q (cms) = 0.2350

### Highlighted

Depth (m) = 0.0823  
Q (cms) = 0.235  
Area (sqm) = 0.1299  
Velocity (m/s) = 1.8092  
Wetted Perim (m) = 4.1923  
Crit Depth, Yc (m) = 0.1219  
Top Width (m) = 4.0231  
EGL (m) = 0.2493

### (Sta, El, n)-(Sta, El, n)...

(0.0000, 61.5500)-(0.3000, 61.4300, 0.013)-(3.9000, 61.5400, 0.013)-(7.5000, 61.4300, 0.013)-(7.8000, 61.4000, 0.013)-(7.8000, 61.5500, 0.013)

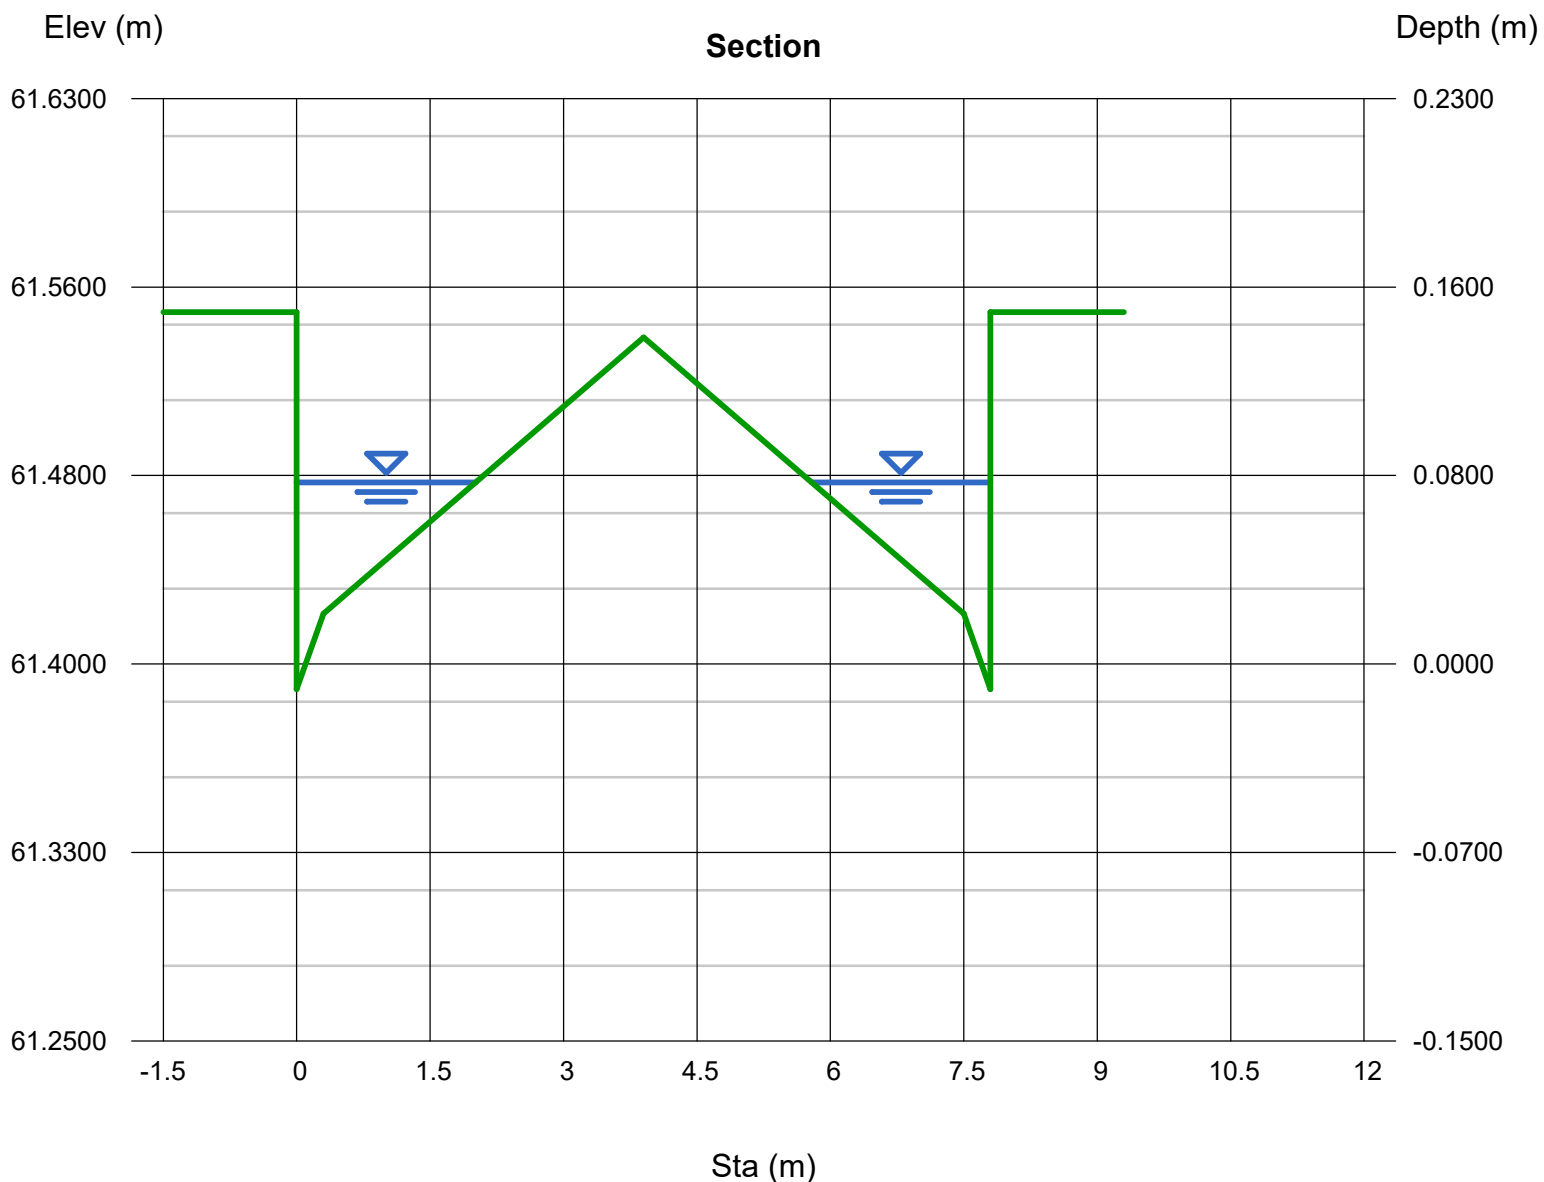

# Channel Report

Hydraflow Express Extension for Autodesk® AutoCAD® Civil 3D® by Autodesk, Inc.

Wednesday, Apr 8 2020

## Section D-D

### User-defined

Invert Elev (m) = 58.0000  
Slope (%) = 1.0000  
N-Value = 0.013

### Calculations


Compute by: Known Q  
Known Q (cms) = 0.2530

### Highlighted

Depth (m) = 0.1311  
Q (cms) = 0.253  
Area (sqm) = 0.2851  
Velocity (m/s) = 0.8873  
Wetted Perim (m) = 7.1039  
Crit Depth, Yc (m) = 0.1433  
Top Width (m) = 6.8970  
EGL (m) = 0.1712

### (Sta, El, n)-(Sta, El, n)...

(0.0000, 58.2100)-(0.3000, 58.0900, 0.013)-(4.4250, 58.1500, 0.013)-(8.5500, 58.0300, 0.013)-(8.8500, 58.0000, 0.013)-(8.8500, 58.1500, 0.013)

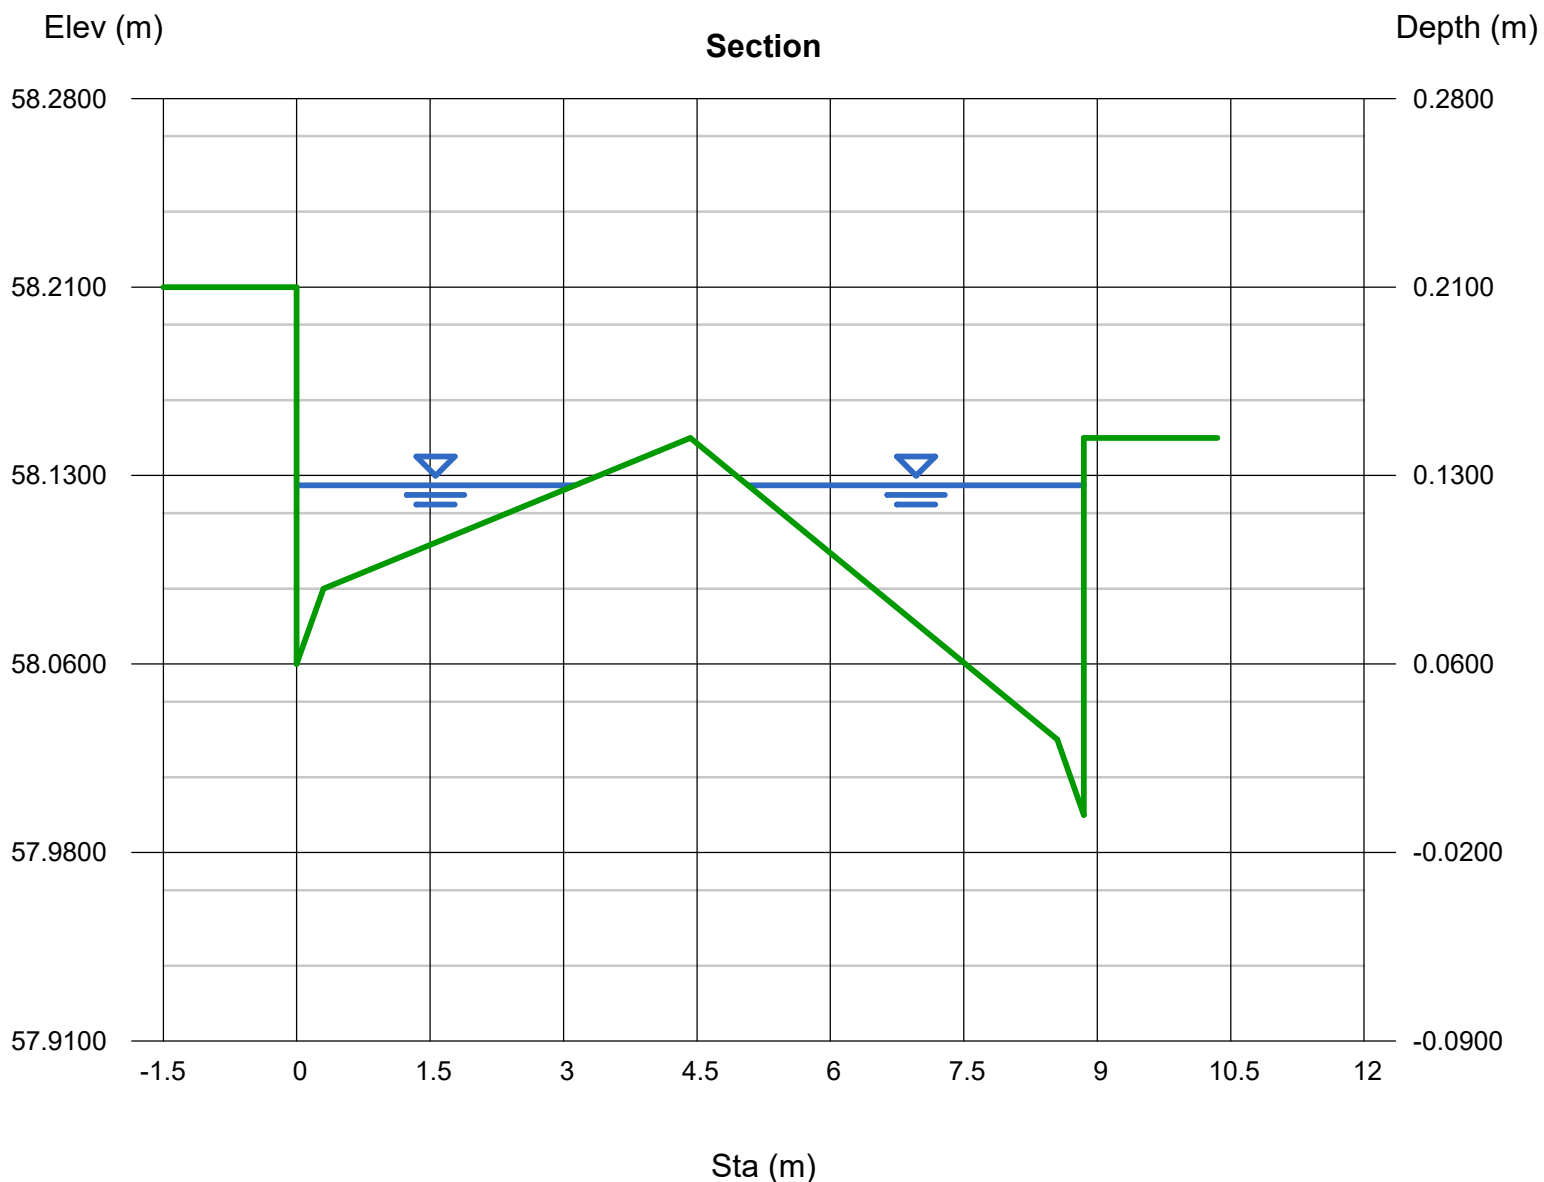

# Channel Report

Hydraflow Express Extension for Autodesk® AutoCAD® Civil 3D® by Autodesk, Inc.

Wednesday, Apr 8 2020

## Section F-F

### User-defined

Invert Elev (m) = 47.7300  
Slope (%) = 2.7000  
N-Value = 0.013

### Calculations

Compute by: Known Q  
Known Q (cms) = 1.0660


### Highlighted

Depth (m) = 0.1890  
Q (cms) = 1.0660  
Area (sqm) = 0.4492  
Velocity (m/s) = 2.3730  
Wetted Perim (m) = 5.4117  
Crit Depth, Yc (m) = 0.2682  
Top Width (m) = 5.2562  
EGL (m) = 0.4762

(Sta, El, n)-(Sta, El, n)...

(0.0000, 47.8800)-(0.1500, 47.7600, 0.013)-(3.9000, 47.8700, 0.013)-(7.5000, 48.0000, 0.013)-(7.8000, 48.0000, 0.013)-(7.8000, 48.1500, 0.013)

looks like over toopping the kerb  
and go into the stream

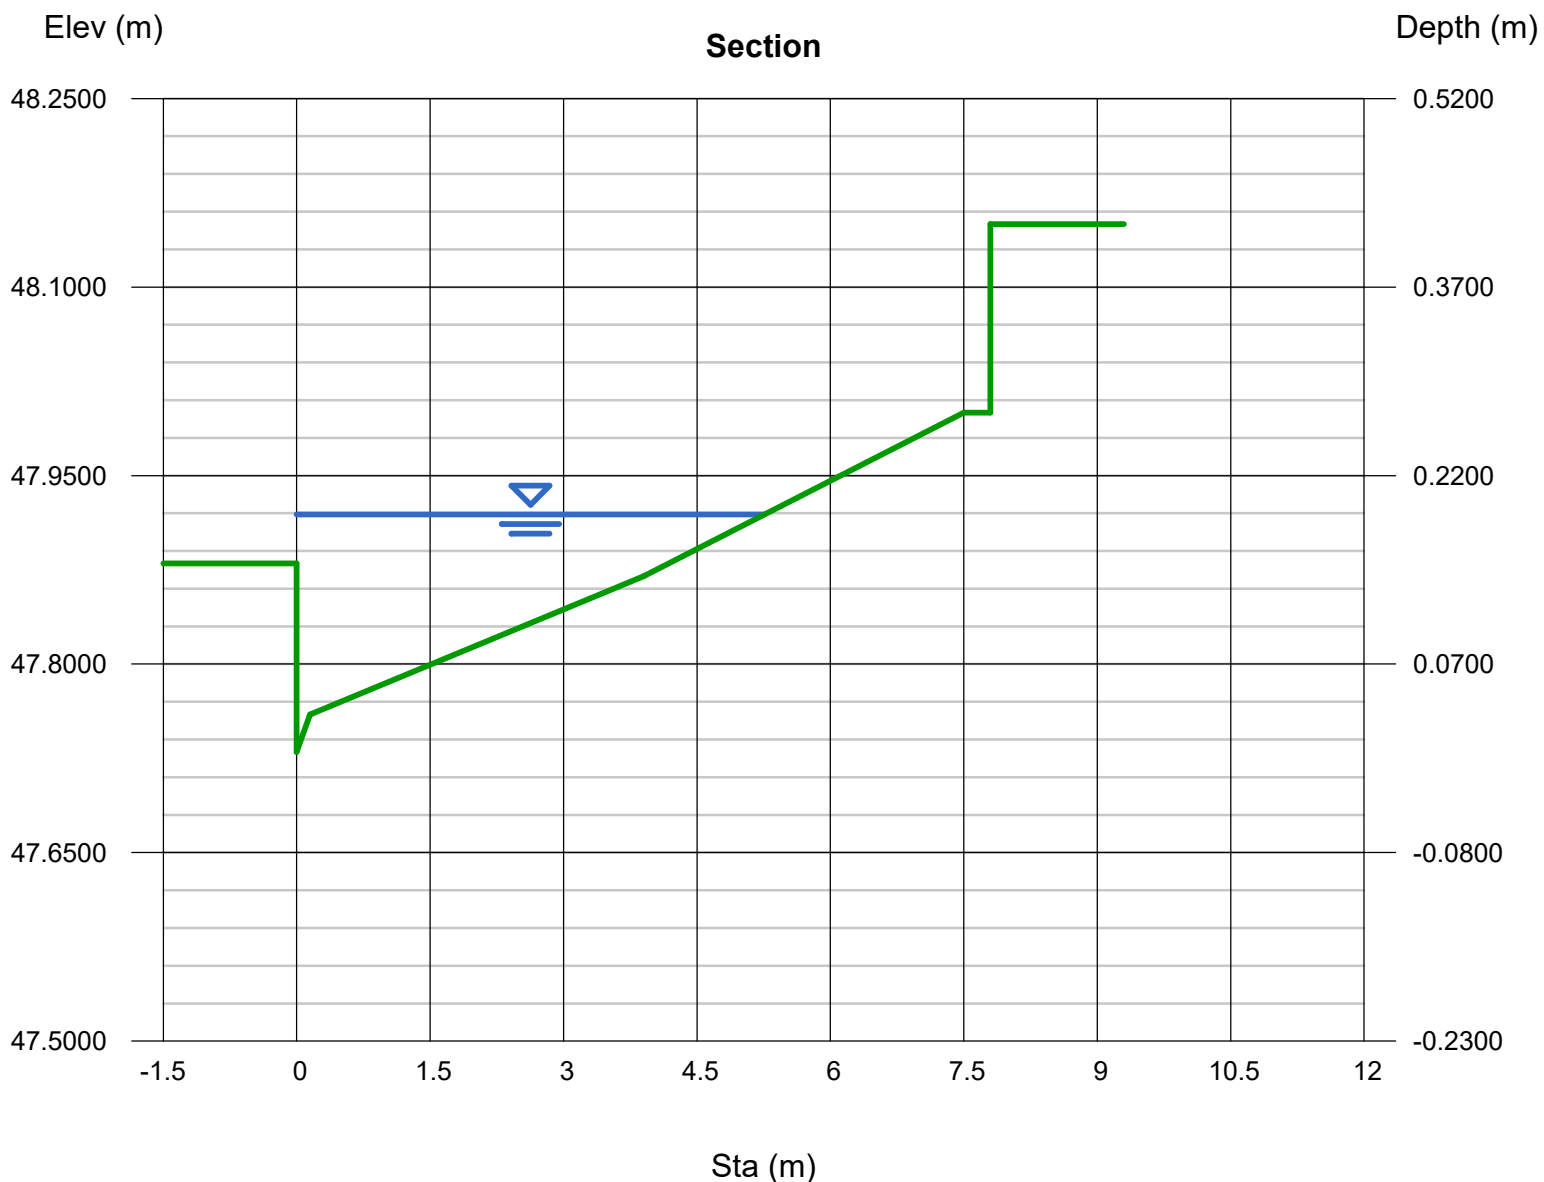

# Channel Report

Hydraflow Express Extension for Autodesk® AutoCAD® Civil 3D® by Autodesk, Inc.

Wednesday, Apr 8 2020

## Section H-H

### User-defined

Invert Elev (m) = 59.3700  
Slope (%) = 2.2000  
N-Value = 0.013

### Calculations


Compute by: Known Q  
Known Q (cms) = 0.2830

### Highlighted

Depth (m) = 0.1006  
Q (cms) = 0.283  
Area (sqm) = 0.2226  
Velocity (m/s) = 1.2713  
Wetted Perim (m) = 5.6588  
Crit Depth, Yc (m) = 0.1280  
Top Width (m) = 5.4526  
EGL (m) = 0.1830

(Sta, El, n)-(Sta, El, n)...

(0.0000, 59.5200)-(0.3000, 59.4000, 0.013)-(4.4250, 59.5200, 0.013)-(8.5500, 59.4000, 0.013)-(8.8500, 59.3700, 0.013)-(8.8500, 59.5200, 0.013)

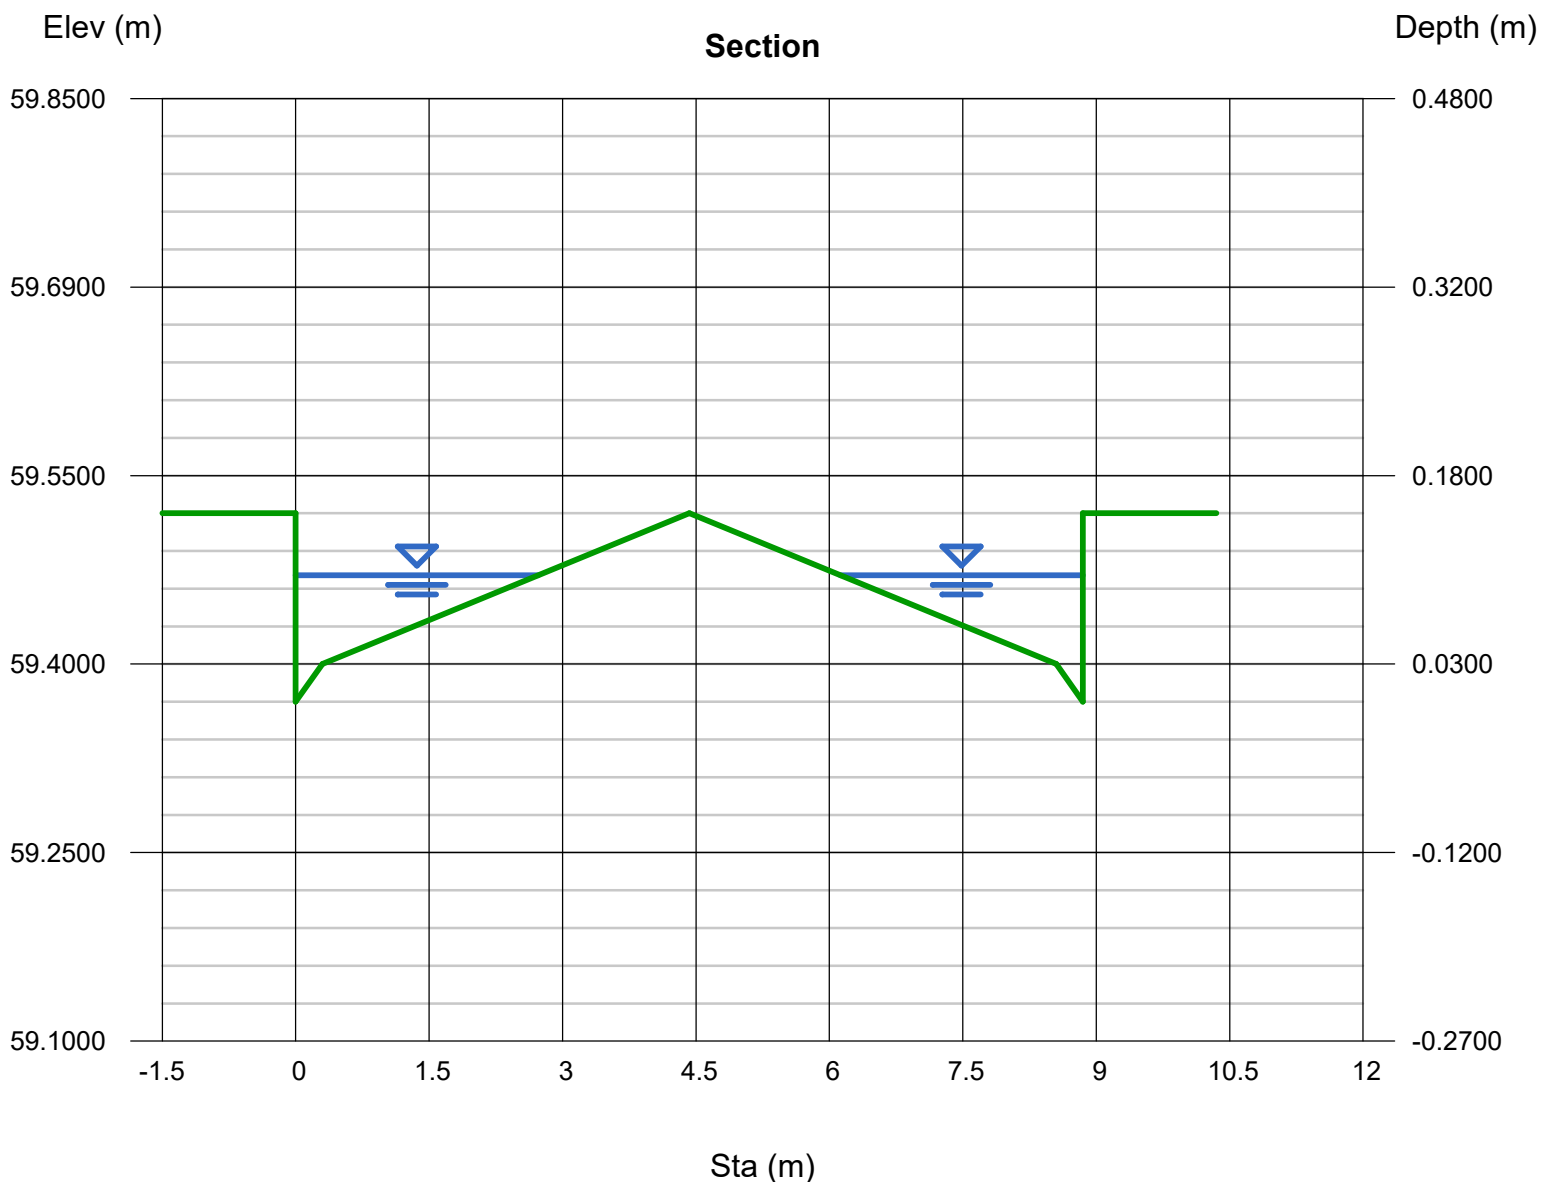

# Channel Report

Hydraflow Express Extension for Autodesk® AutoCAD® Civil 3D® by Autodesk, Inc.

Wednesday, Apr 8 2020

## Section I-I

### User-defined

Invert Elev (m) = 60.2000  
Slope (%) = 4.9000  
N-Value = 0.013

### Calculations


Compute by: Known Q  
Known Q (cms) = 0.1730

### Highlighted

Depth (m) = 0.0975  
Q (cms) = 0.173  
Area (sqm) = 0.0994  
Velocity (m/s) = 1.7403  
Wetted Perim (m) = 2.6104  
Crit Depth, Yc (m) = 0.1402  
Top Width (m) = 2.5104  
EGL (m) = 0.2520

(Sta, El, n)-(Sta, El, n)...

(0.0000, 60.3400)-(3.6000, 60.2300, 0.013)-(3.9000, 60.2000, 0.013)-(3.9000, 60.3500, 0.013)

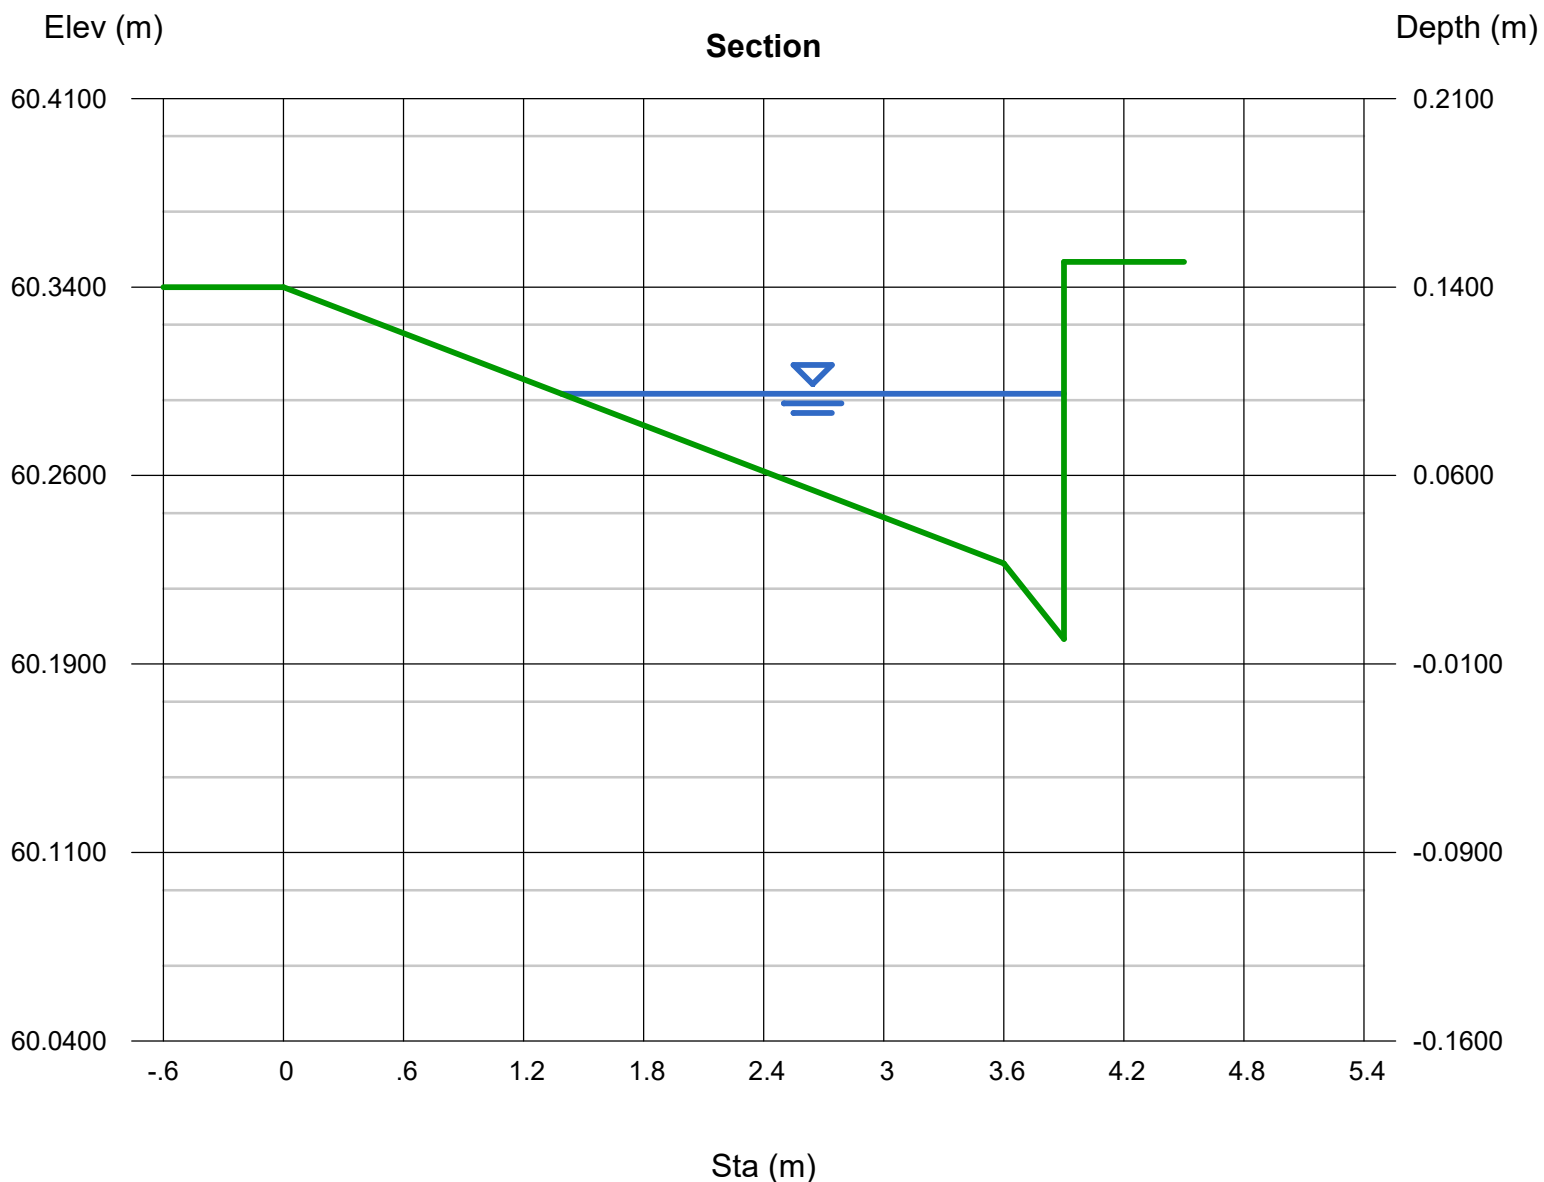

# Channel Report

Hydraflow Express Extension for Autodesk® AutoCAD® Civil 3D® by Autodesk, Inc.

Wednesday, Apr 8 2020

## Section J-J

### User-defined

Invert Elev (m) = 51.7000  
Slope (%) = 4.9000  
N-Value = 0.013

### Calculations


Compute by: Known Q  
Known Q (cms) = 0.7130

### Highlighted

Depth (m) = 0.1189  
Q (cms) = 0.7130  
Area (sqm) = 0.3208  
Velocity (m/s) = 2.2224  
Wetted Perim (m) = 6.6607  
Crit Depth, Yc (m) = 0.1500  
Top Width (m) = 6.4173  
EGL (m) = 0.3708

### (Sta, El, n)-(Sta, El, n)...

(0.0000, 51.8500)-(0.3000, 51.7300, 0.013)-(3.9000, 51.8400, 0.013)-(7.5000, 51.7300, 0.013)-(7.8000, 51.7000, 0.013)-(7.8000, 51.8500, 0.013)

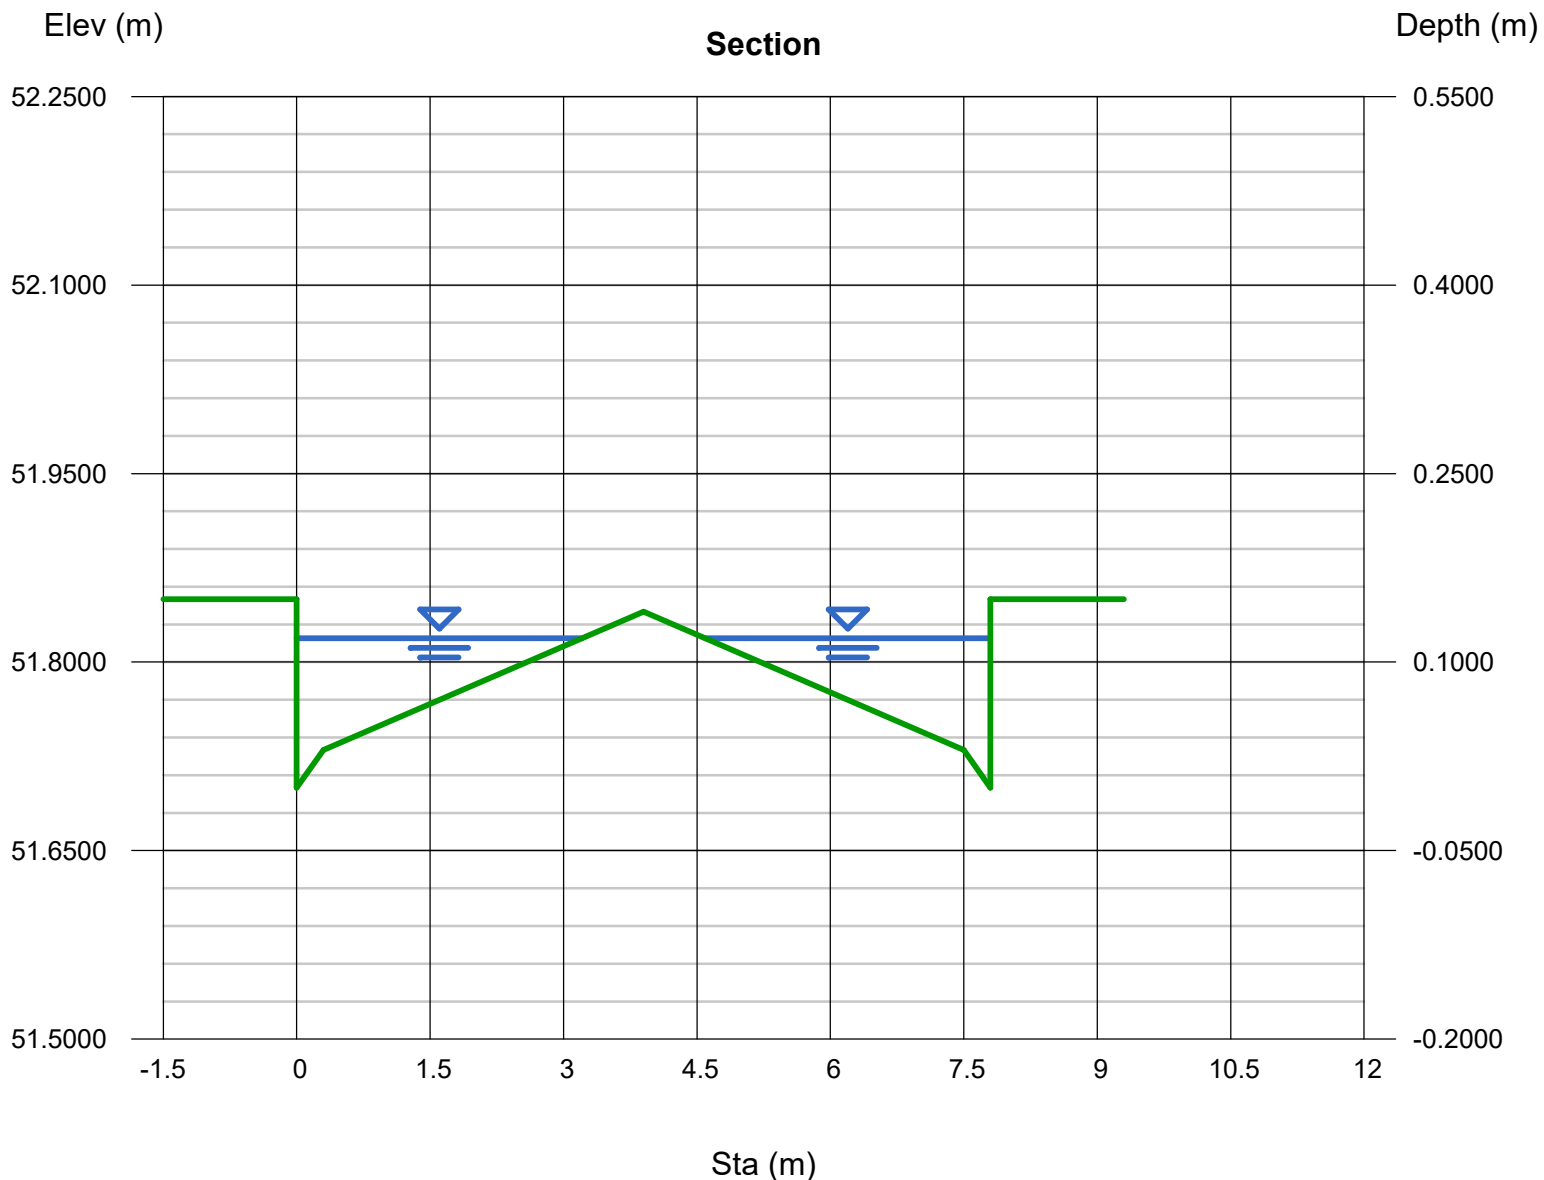

# Channel Report

Hydraflow Express Extension for Autodesk® AutoCAD® Civil 3D® by Autodesk, Inc.

Wednesday, Apr 8 2020

## Section K-K

### User-defined

Invert Elev (m) = 49.8300  
Slope (%) = 3.0000  
N-Value = 0.013

### Calculations


Compute by: Known Q  
Known Q (cms) = 0.4540

### Highlighted

Depth (m) = 0.1097  
Q (cms) = 0.4540  
Area (sqm) = 0.2857  
Velocity (m/s) = 1.5891  
Wetted Perim (m) = 6.5653  
Crit Depth, Yc (m) = 0.1463  
Top Width (m) = 6.3406  
EGL (m) = 0.2385

### (Sta, El, n)-(Sta, El, n)...

(0.0000, 49.9800)-(0.3000, 49.8600, 0.013)-(3.9000, 49.9600, 0.013)-(7.5000, 49.8600, 0.013)-(7.8000, 49.8300, 0.013)-(7.8000, 49.9800, 0.013)

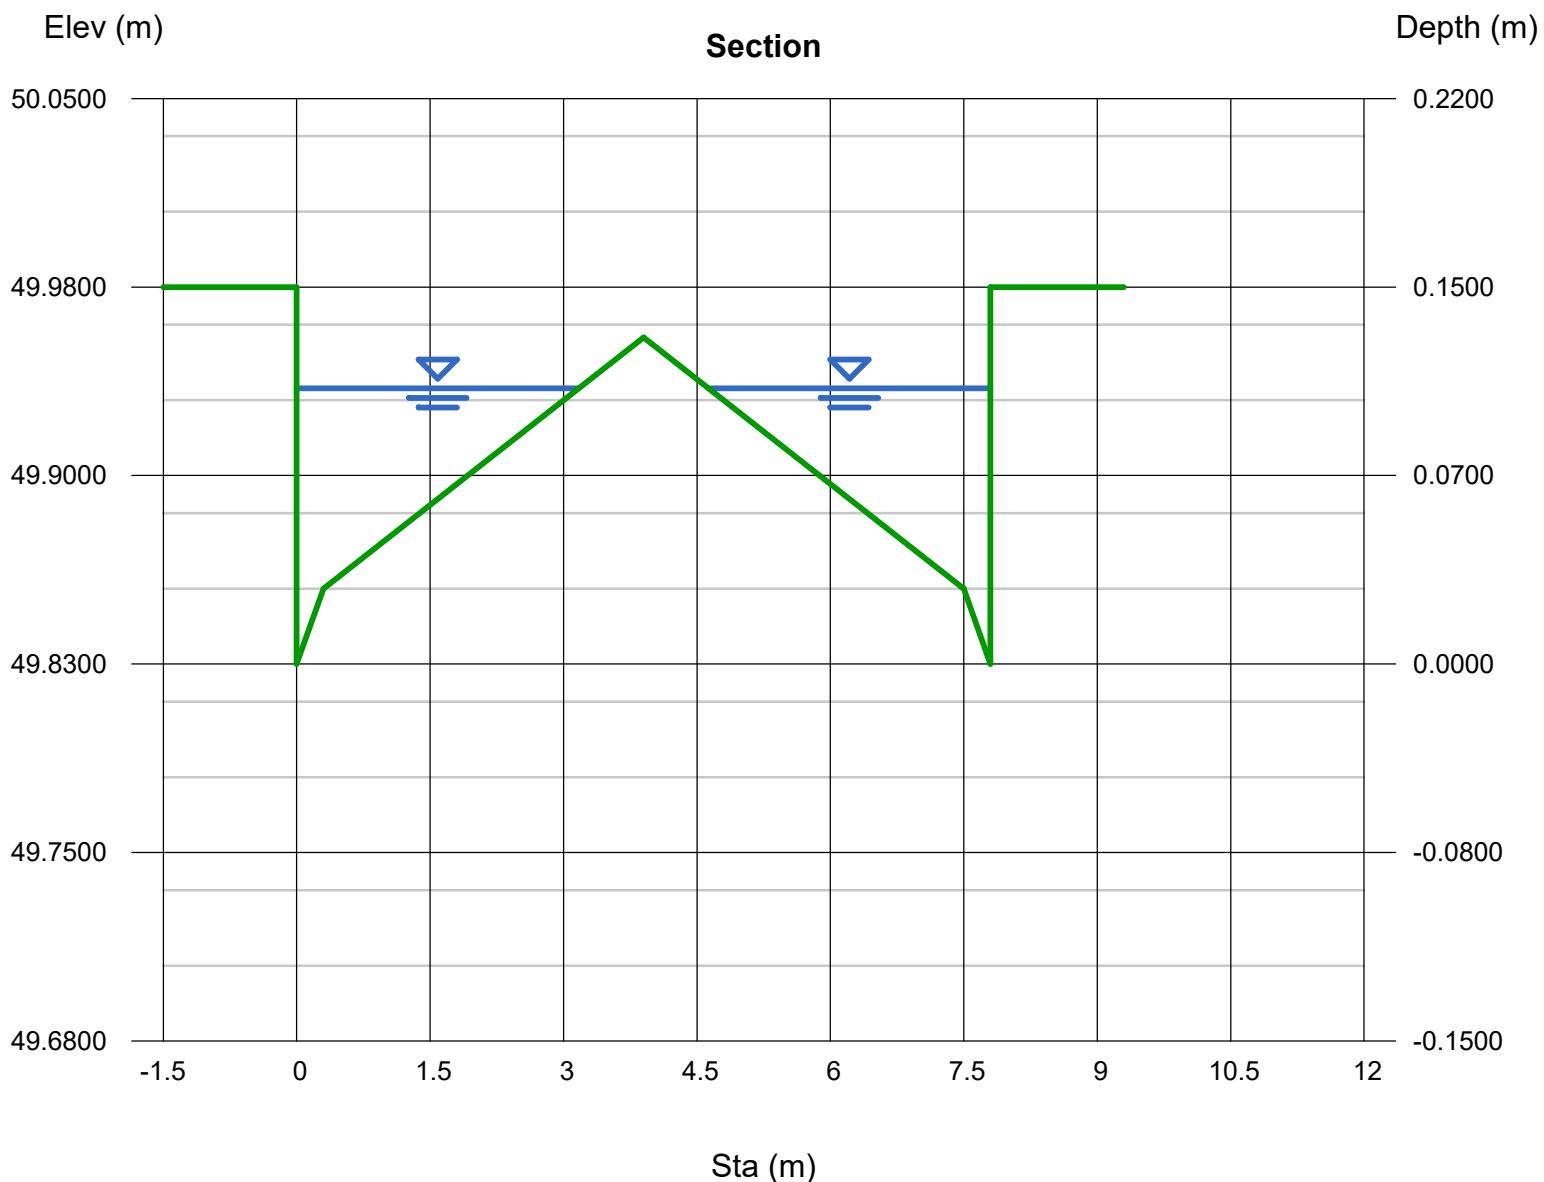

# Channel Report

Hydraflow Express Extension for Autodesk® AutoCAD® Civil 3D® by Autodesk, Inc.

Wednesday, Apr 15 2020

## Section M-M

### User-defined

Invert Elev (m) = 48.1100  
Slope (%) = 0.9000  
N-Value = 0.013

### Calculations


Compute by: Known Q  
Known Q (cms) = 1.0740

### Highlighted

Depth (m) = 0.2195  
Q (cms) = 1.0740  
Area (sqm) = 0.7616  
Velocity (m/s) = 1.4101  
Wetted Perim (m) = 8.6731  
Crit Depth, Yc (m) = 0.2499  
Top Width (m) = 8.5000  
EGL (m) = 0.3209

(Sta, El, n)-(Sta, El, n)...

(0.0000, 48.2600)-(0.3000, 48.1400, 0.013)-(4.2500, 48.2600, 0.013)-(8.5000, 48.3100, 0.013)-(8.5000, 48.4600, 0.013)

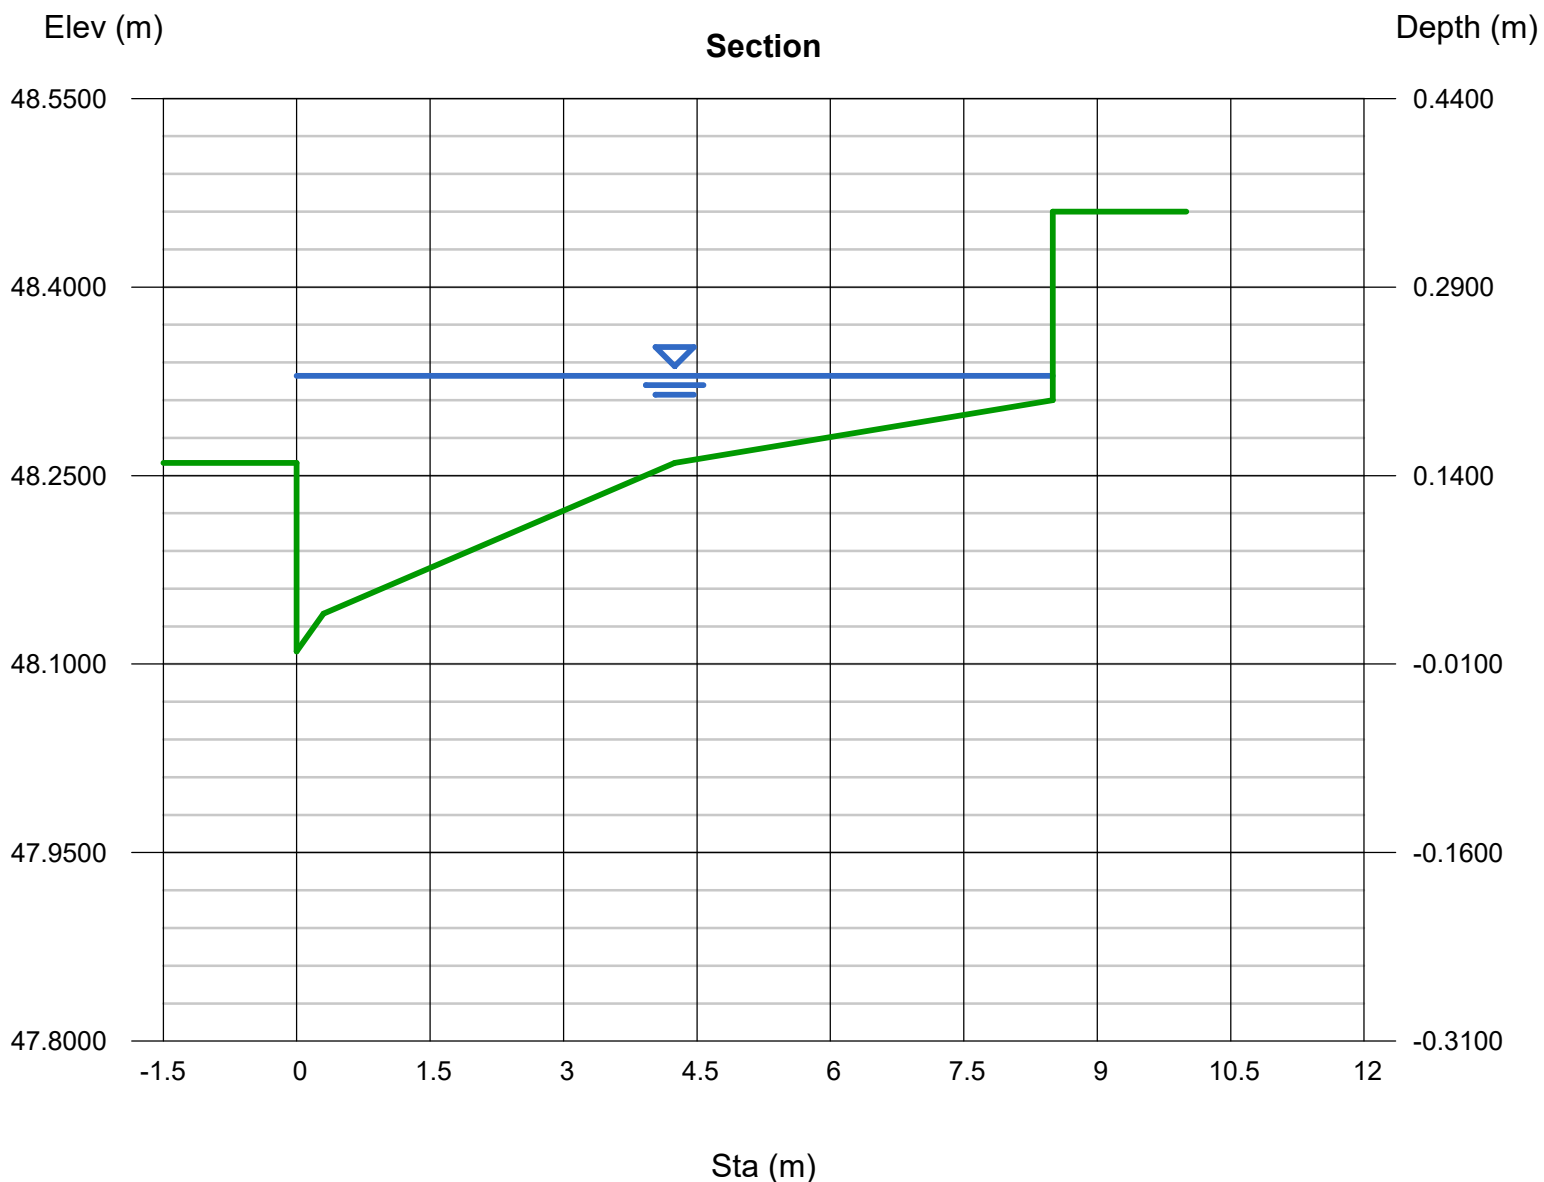



# Channel Report

Hydraflow Express Extension for Autodesk® AutoCAD® Civil 3D® by Autodesk, Inc.

Wednesday, Jul 22 2020

## Section O-O

### User-defined

Invert Elev (m) = 66.7600  
Slope (%) = 5.0000  
N-Value = 0.013

### Calculations


Compute by: Known Q  
Known Q (cms) = 0.3200

### Highlighted

Depth (m) = 0.1341  
Q (cms) = 0.3200  
Area (sqm) = 0.1158  
Velocity (m/s) = 2.7632  
Wetted Perim (m) = 1.7481  
Crit Depth, Yc (m) = 0.2103  
Top Width (m) = 1.4518  
EGL (m) = 0.5236

### (Sta, El, n)-(Sta, El, n)...

(0.0000, 66.9100)-(0.3000, 66.7900, 0.013)-(0.7500, 66.9000, 0.013)-(3.9000, 66.9800, 0.013)-(7.0500, 66.9000, 0.013)-(7.5000, 66.7900, 0.013)-(7.8000, 66.7900, 0.013)-(7.8000, 66.9100, 0.013)

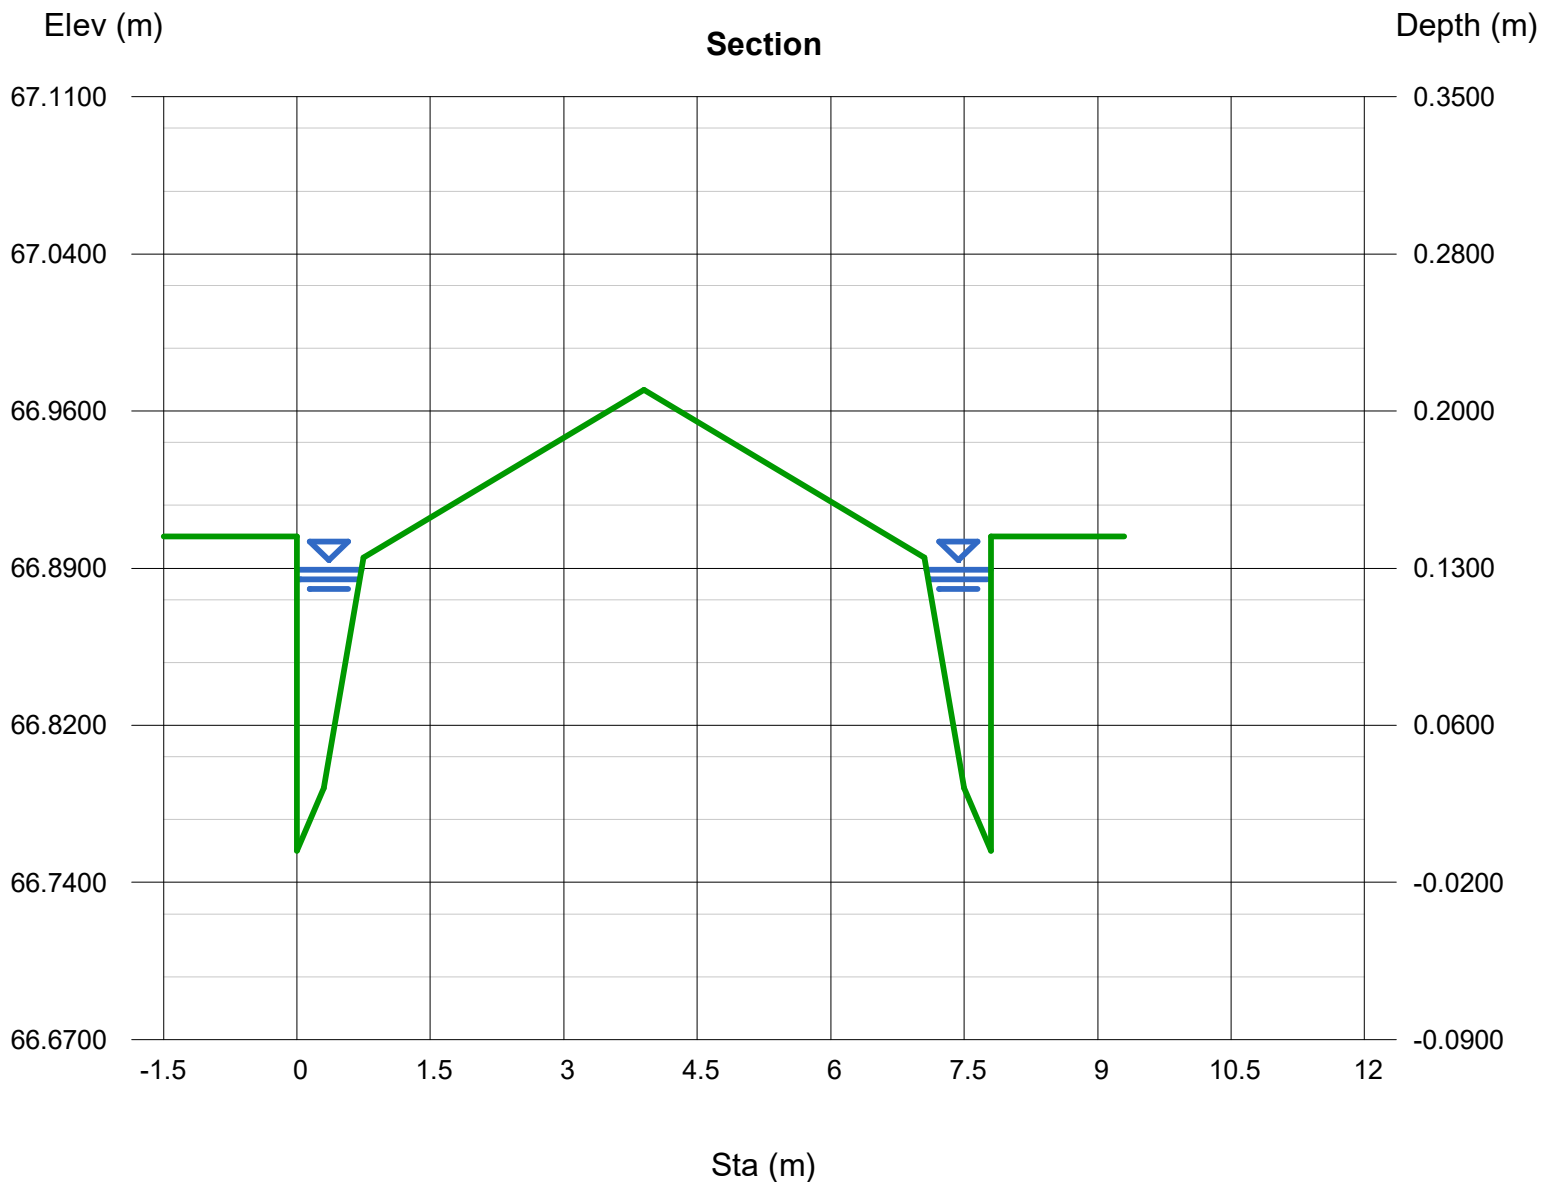

# Channel Report

Hydraflow Express Extension for Autodesk® AutoCAD® Civil 3D® by Autodesk, Inc.

Wednesday, Jul 22 2020

## Section P-P

### User-defined

Invert Elev (m) = 62.0800  
Slope (%) = 5.7000  
N-Value = 0.013

### Calculations


Compute by: Known Q  
Known Q (cms) = 0.1840

### Highlighted

Depth (m) = 0.0945  
Q (cms) = 0.184  
Area (sqm) = 0.0734  
Velocity (m/s) = 2.5070  
Wetted Perim (m) = 1.4177  
Crit Depth, Yc (m) = 0.1737  
Top Width (m) = 1.2095  
EGL (m) = 0.4151

### (Sta, El, n)-(Sta, El, n)...

(0.0000, 62.2300)-(0.3000, 62.1000, 0.013)-(0.7500, 62.2100, 0.013)-(3.9000, 62.3100, 0.013)-(7.0500, 62.2100, 0.013)-(7.5000, 62.1000, 0.013)-(7.8000, 62.0800, 0.013)

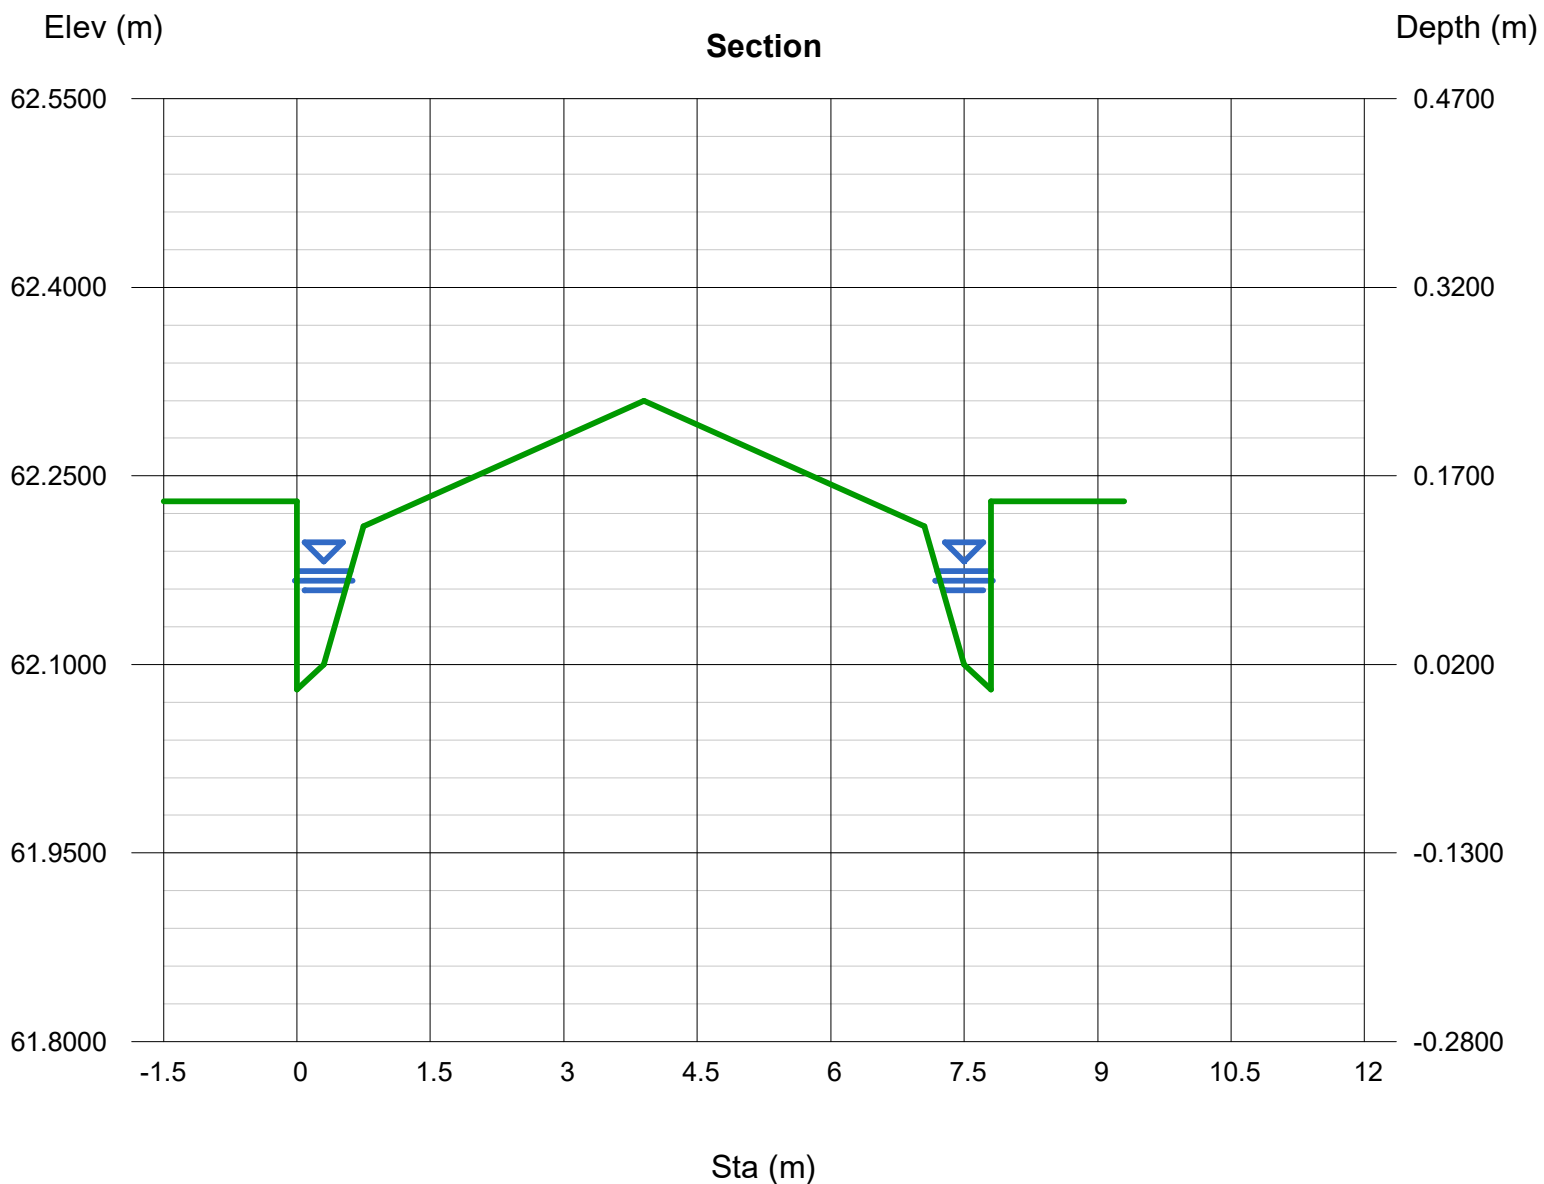

# Channel Report

Hydraflow Express Extension for Autodesk® AutoCAD® Civil 3D® by Autodesk, Inc.

Wednesday, Jul 22 2020

## Section Q-Q

### User-defined

Invert Elev (m) = 63.0200  
Slope (%) = 8.1000  
N-Value = 0.013

### Calculations

Compute by: Known Q  
Known Q (cms) = 0.1300

### Highlighted

Depth (m) = 0.0762  
Q (cms) = 0.130  
Area (sqm) = 0.0526  
Velocity (m/s) = 2.4695  
Wetted Perim (m) = 1.2271  
Crit Depth, Yc (m) = 0.1554  
Top Width (m) = 1.0598  
EGL (m) = 0.3873

### (Sta, El, n)-(Sta, El, n)...

(0.0000, 63.1700)-(0.3000, 63.0400, 0.013)-(0.7500, 63.1500, 0.013)-(3.9000, 63.2400, 0.013)-(7.0500, 63.1500, 0.013)-(7.5000, 63.0400, 0.013)-(7.8000, 63.0400, 0.013)-(7.8000, 63.1700, 0.013)

