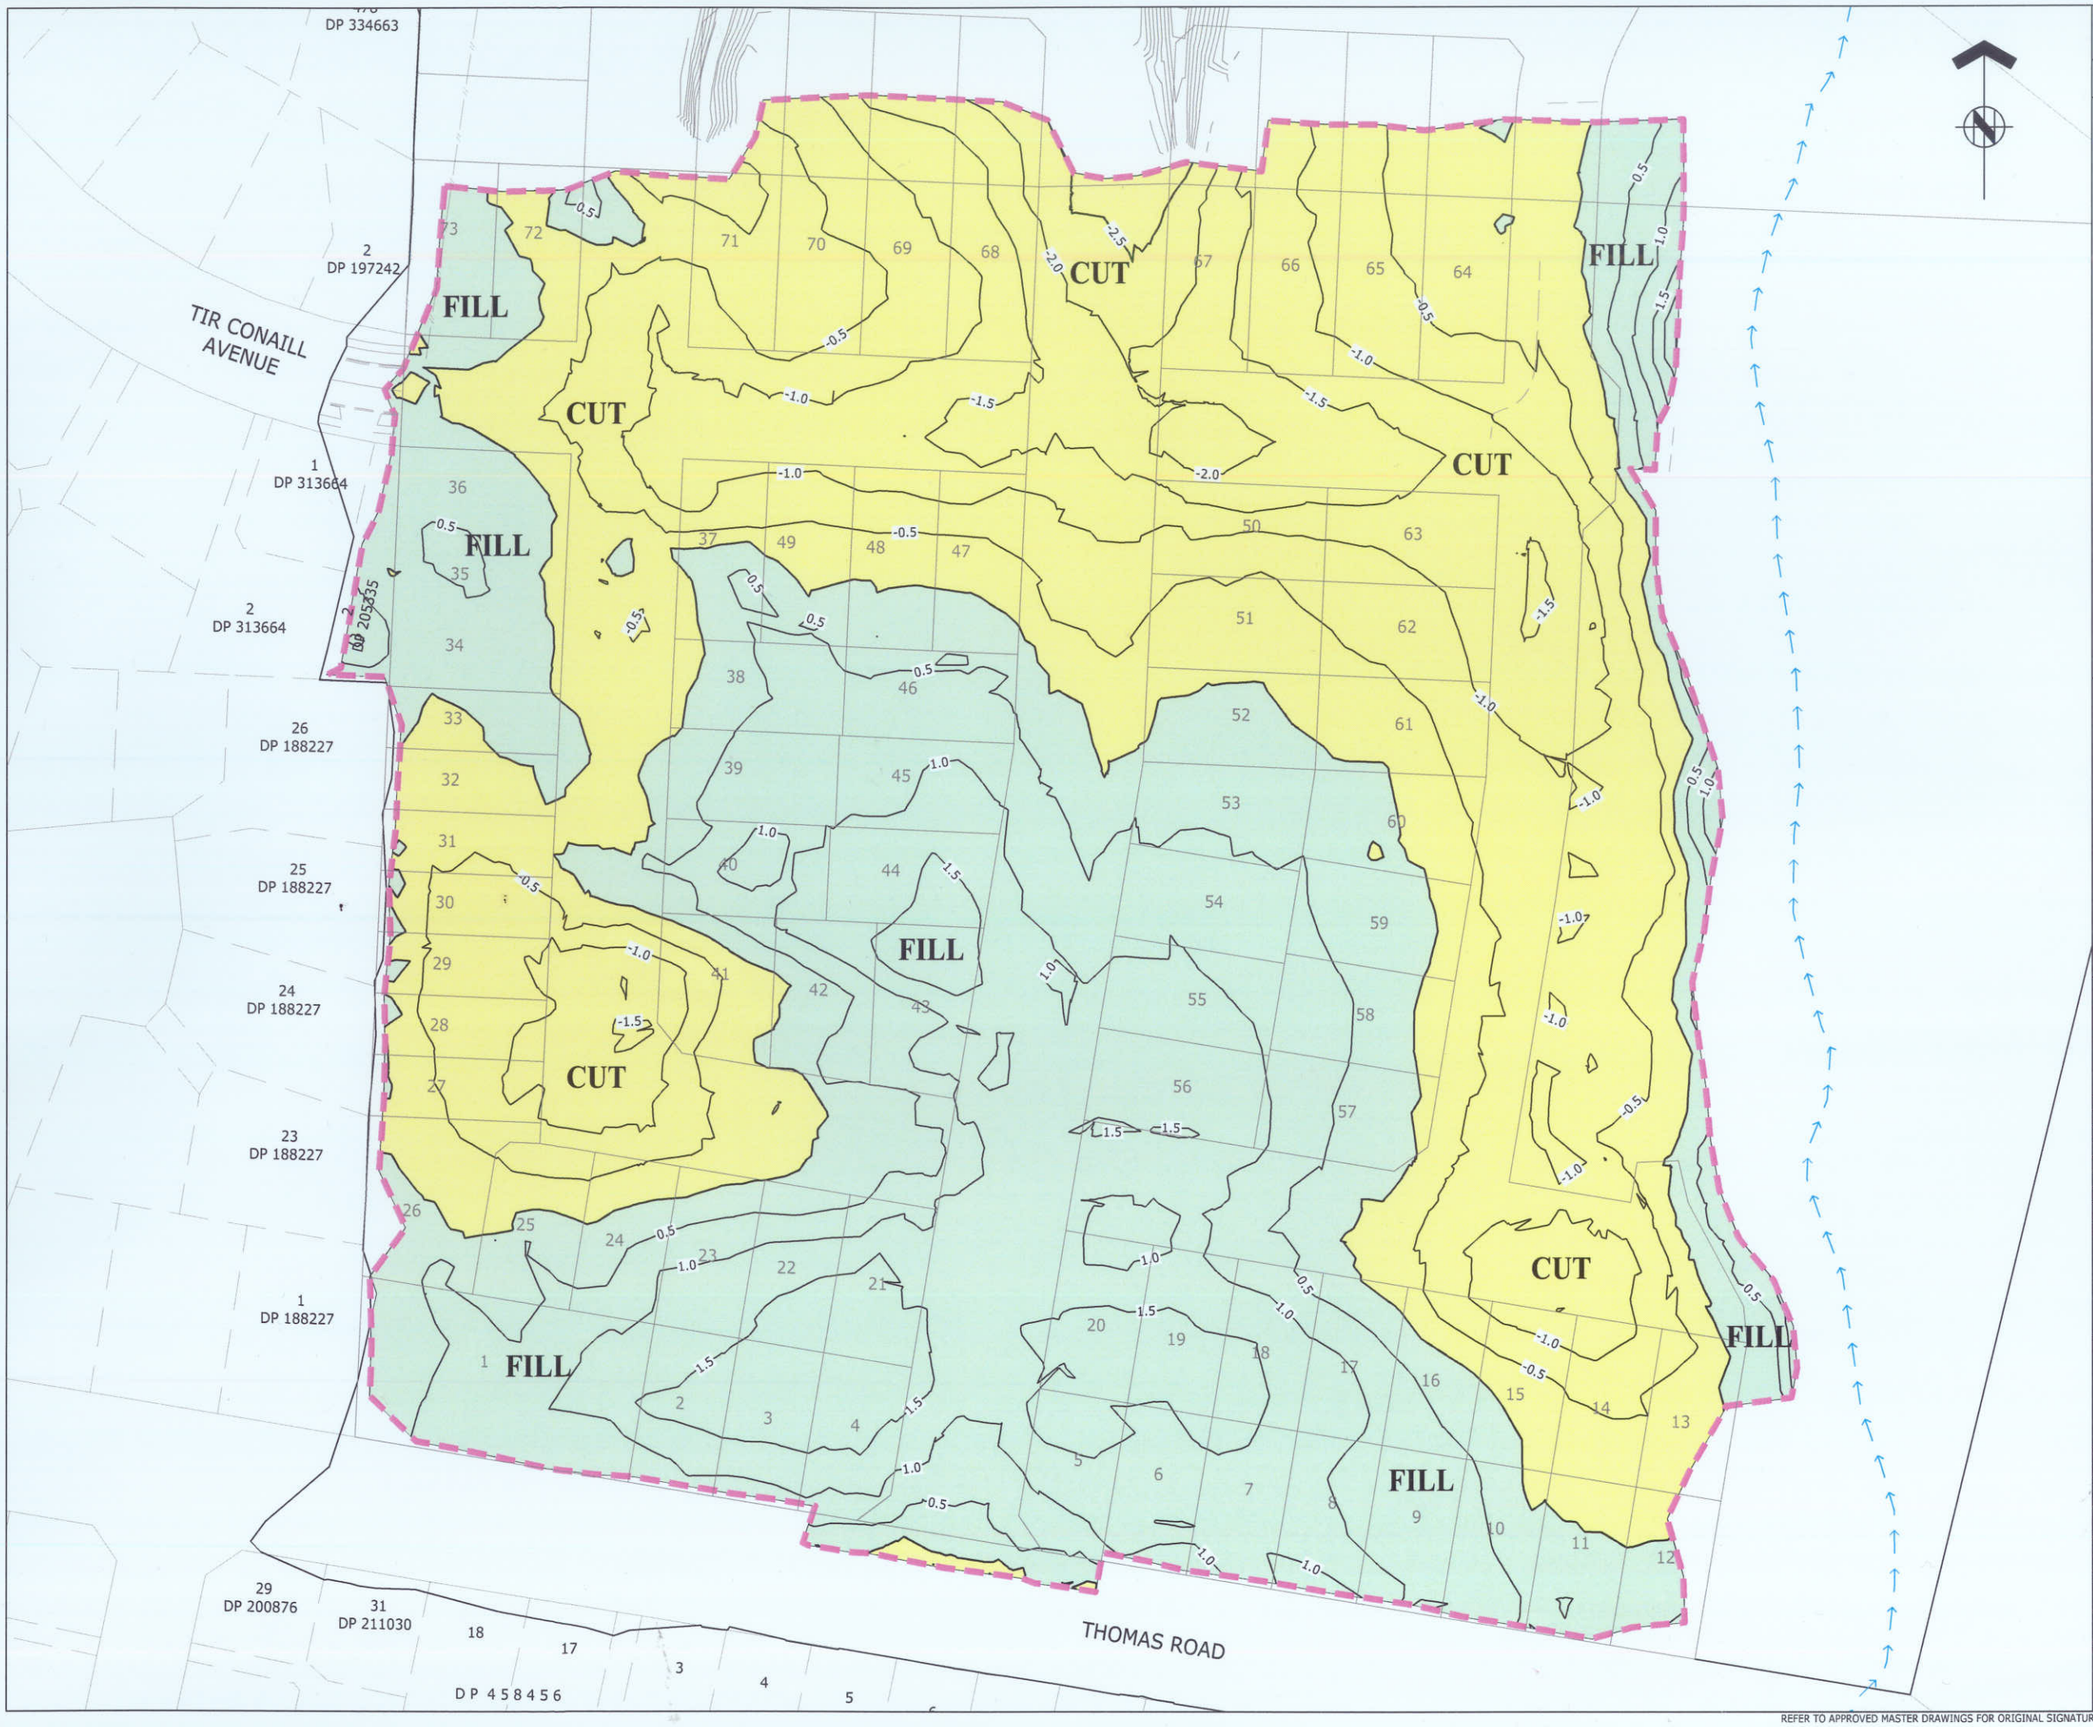

ASSOCIATION OF CONSULTING ENGINEERS NEW ZEALAND
ACENZ
ISO 9001 QUALITY ASSURED

THIS DRAWING AND DESIGN REMAINS THE PROPERTY OF, AND MAY NOT BE REPRODUCED OR ALTERED, WITHOUT THE WRITTEN PERMISSION OF HARRISON GRIERSON CONSULTANTS LIMITED. NO LIABILITY SHALL BE ACCEPTED FOR UNAUTHORISED USE OF THIS DRAWING.

NOTES:

1. ORIGIN OF LEVELS
   S 66 SO 48643
   RL 54.50m
2. ORIGIN OF COORDINATES
   S 66 SO 48643
   5905356.71mN
   1770941.22mE

LEGEND

- 1.0 — FILL CONTOUR
- -1.0 — CUT CONTOUR
- EXTENT OF EARTHWORKS
- CUT
- FILL

ENGINEERING APPROVAL
ENG-48683

I CERTIFY THAT THESE ASBUILT PLANS ARE AN ACCURATE RECORD OF THE WORKS UNDERTAKEN AND THAT:

- THE COORDINATES (X,Y) ARE IN TERMS OF NZTM ON NZGD (2000), AND ARE WITHIN ±50mm.
- THE LEVELS (Z) ARE IN TERMS OF THE AUCKLAND 1946 (MSL) LINZ DATUM (DOSLI DATUM), AND ARE WITHIN ±25mm.

Signed: .....
CHARTERED PROFESSIONAL ENGINEER

Date: 28.11.16

Name: WILLIAM PLATTS

Phone: 09-917-5000

Email: w.platts@harrisongrierson.com

AUCKLAND OFFICE
DILWORTH HOUSE 71 GREAT SOUTH ROAD
NEWMARKET AUCKLAND 1051
T +64 9 917 5000
W www.harrisongrierson.com

REF	REVISIONS	BY	DATE
A	AS-BUILT	WJP	28.11.16

PROJECT:

DONEGAL STUD
THOMAS ROAD
FLAT BUSH

TITLE:

STAGE 8
CUT FILL AS-BUILT

ORIGINATOR: SXK	DATE: 10.2016	SIGNED:	PLOT BY: BKB
DRAWN: BB	DATE: 10.2016	SIGNED:	PLOT DATE: 28.11.16
CHECKED: SXK	DATE: 28.11.16	SIGNED:	SURVEY BY: MJS
APPROVED: WJP	DATE: 28.11.16	SIGNED:	SURVEY DATE: 10.2016

ISSUE STATUS: AS-BUILT

PROJECT No: 1050-132822-01	SCALES: 1:500-A1 1:1000-A3	A1
DRAWING No: 136822-AB220		REV A